

NO WELLS WITH IN 200'

# SEPTIC MAP


## #6

# LAUREL PARK

2001

ROUTE 10 STATE HIGHWAY  
PARAVIEW

PROPERTY LINE

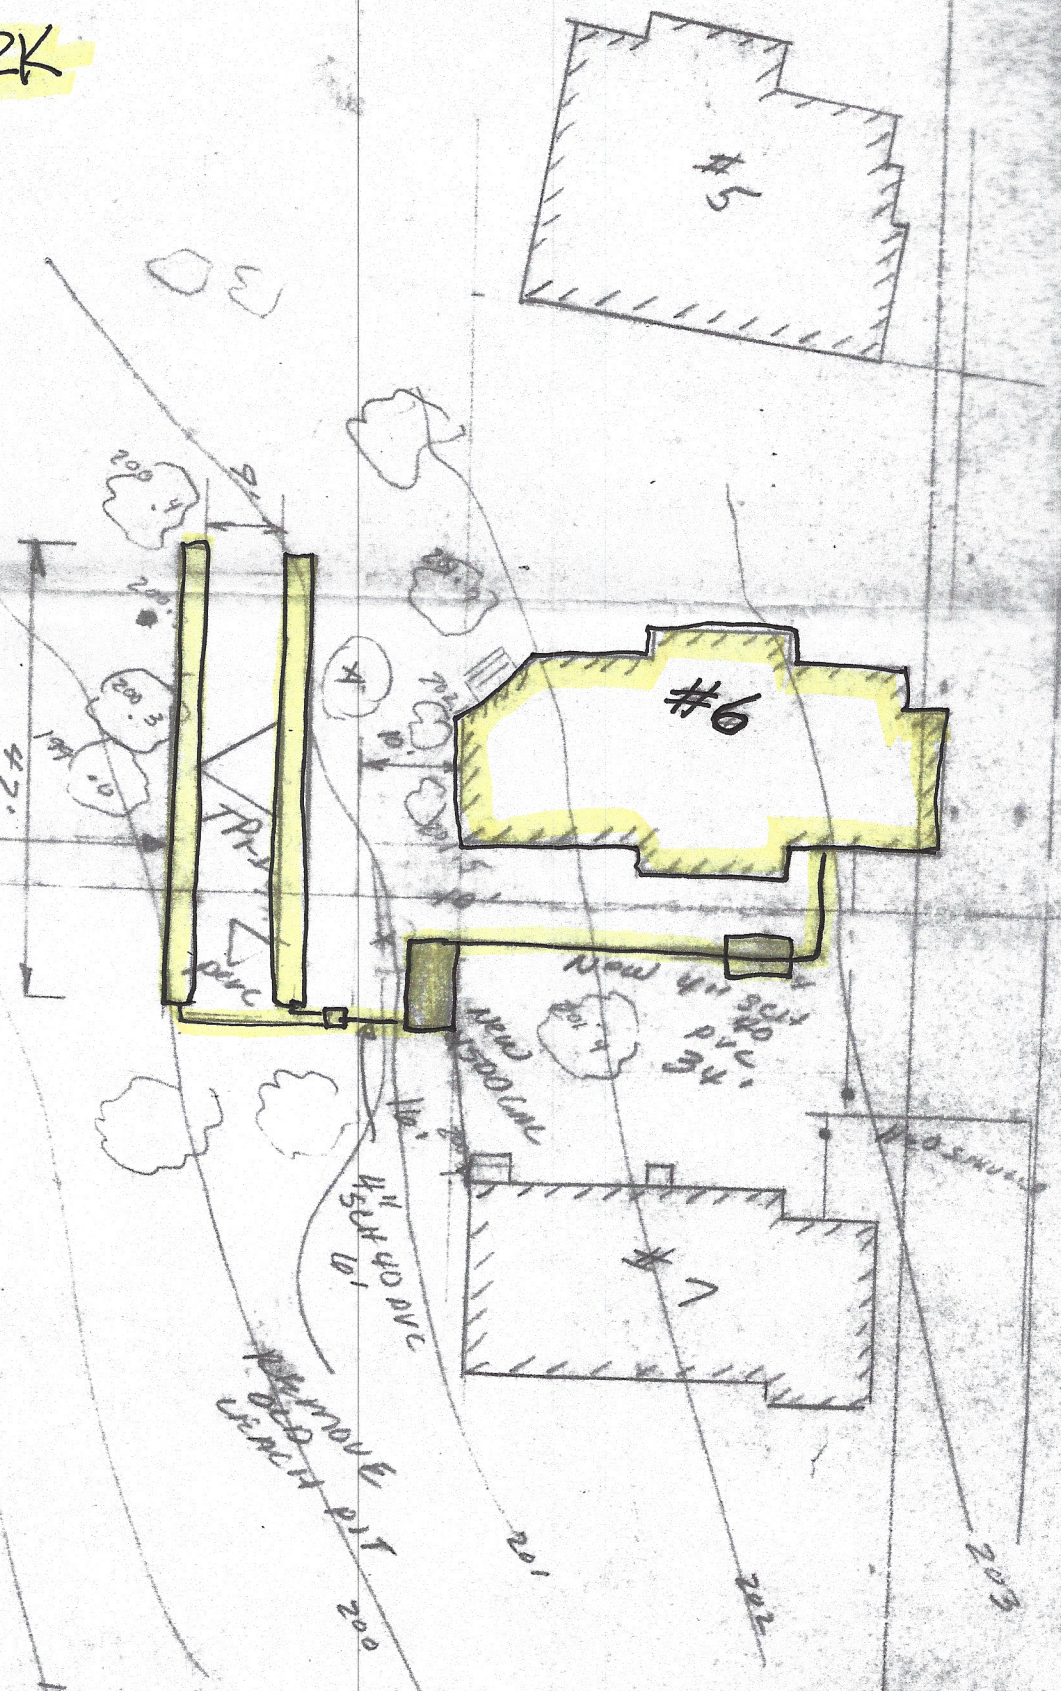

NO WELLS WITH IN 200'