


PLAT

Public H₂O

H₂O SERVICE

SEWER

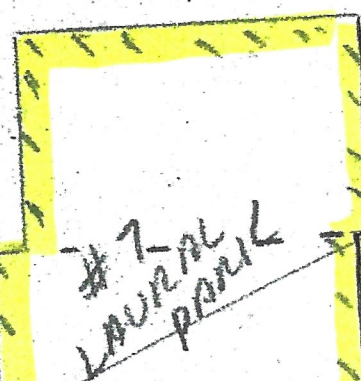

3 BEDROOMS
NO DISPOSAL


PORCH
NO BMT



OLD TEST PIT

25' SCH 40 PVC

NO WELLS WITH IN 300'

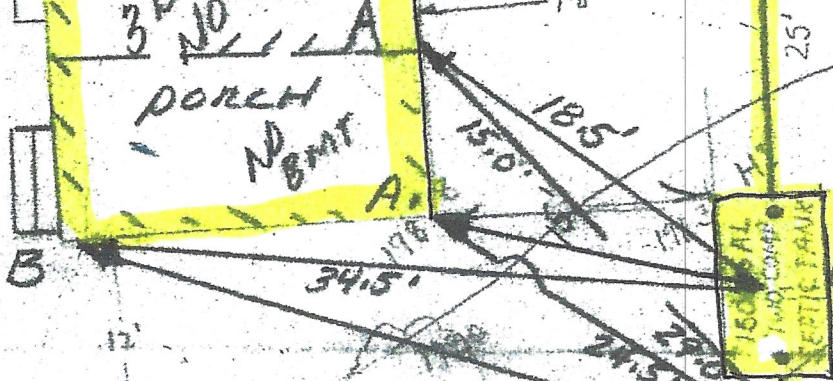

150 GALS
1000 COMP
SEPTIC TANK


4" SCH 40
DIST. BOX

4" SDR 35
SOUND
197

1975




SEPTIC MAP
7
LAUREL PARK

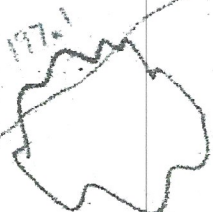

1910

49'

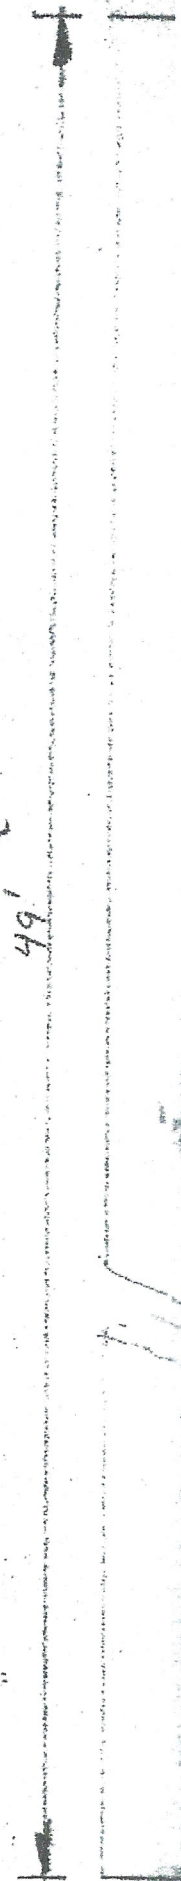

1935