


Septic Map - Unit #11 / 2005

OFFICIAL INSPECTION FORM - NOT FOR VOLUNTARY ASSESSMENTS SUBSURFACE SEWAGE DISPOSAL SYSTEM INSPECTION FORM PART C SYSTEM INFORMATION (continued)


Property Address: 11 LAUREL PARK
NORTHAMPTON MA
Owner: M. LEITON
Date of Inspection: 7/9/05

SKETCH OF SEWAGE DISPOSAL SYSTEM

Provide a sketch of the sewage disposal system including ties to at least two permanent reference landmarks or benchmarks. Locate all wells within 100 feet. Locate where public water supply enters the building.

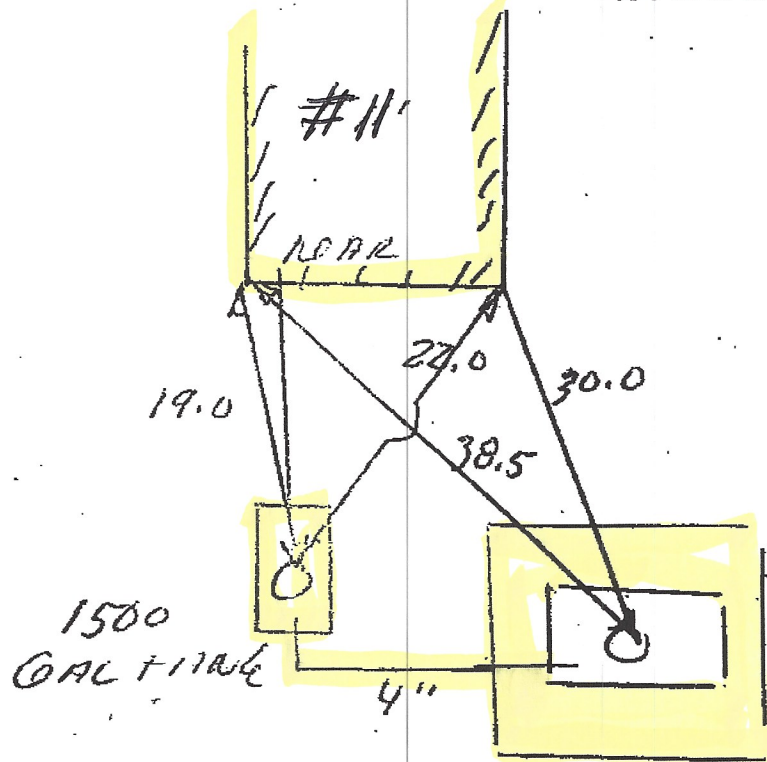

LEACHING PIT
(DRY WORKING) well
10'6" x 5' x 3'
4 FT STONE SIDES
EFFECTIVE DEPTH 2'
EFFECTIVE DEPTH 13'
18'

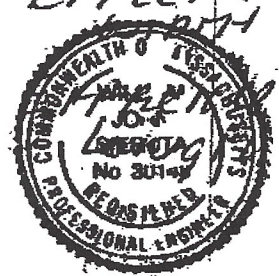

Frank Barnett-Mills
11 Laurel Park
No. Ho. 413-341-3168