
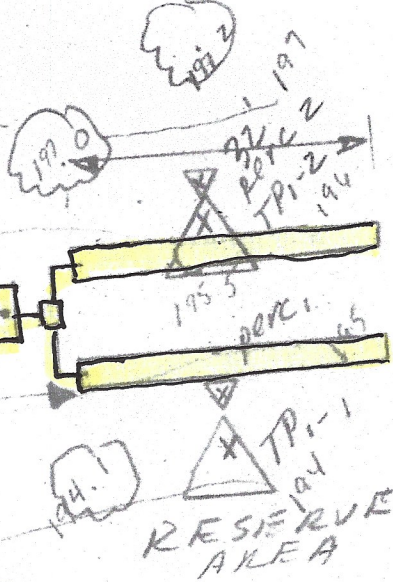
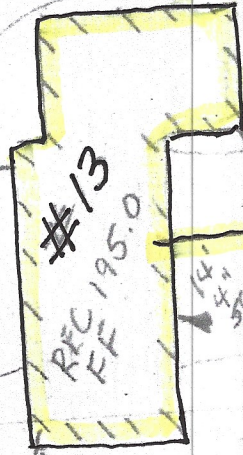


NO WELLS WITHIN 200'

#40

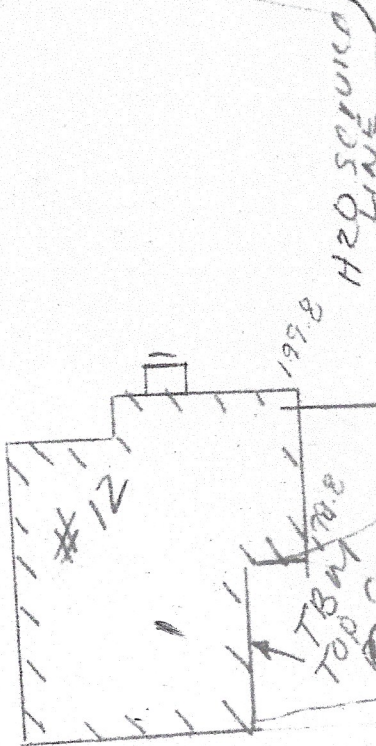

TO BE WALKWAY

RESERVE AREA

END POST OF FENCE

194  
193  
192

PROP LINE

EDGE PAVE


SEPTIC SYSTEM  
 MAP # 13  
 LAUREL PARK

NORTH KING STREET  
 ROUTE 5/10

2011

NO WELLS WITHIN 200'

PLAN VIEW SCALE

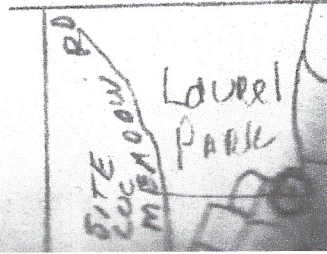

NO WELLS WITHIN 200'