

Unit # 17 SEPTIC LAUREL PARK

SEPTIC
PROPERTY
REQUIRES VARIANCE
FROM ZONING
ORDINANCE

4" PVC PERFORATED
DISTRIBUTION PIPES.
SLOPE 0.005

18" PIPE

DISTRIBUTION BOX



1500 GALLON
SEPTIC TANK

TEST PIT
5/23/86

BUILDING SEWER
SLOPE 0.010

30' SEPTIC FIELD
40' x 15' x 1.5'

30' x 12' LEAKY FIELD

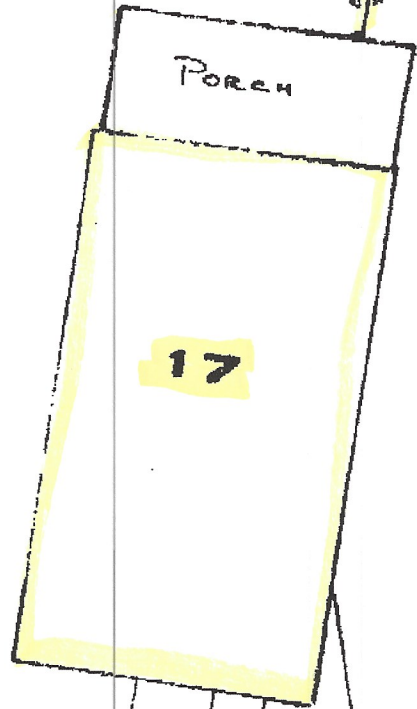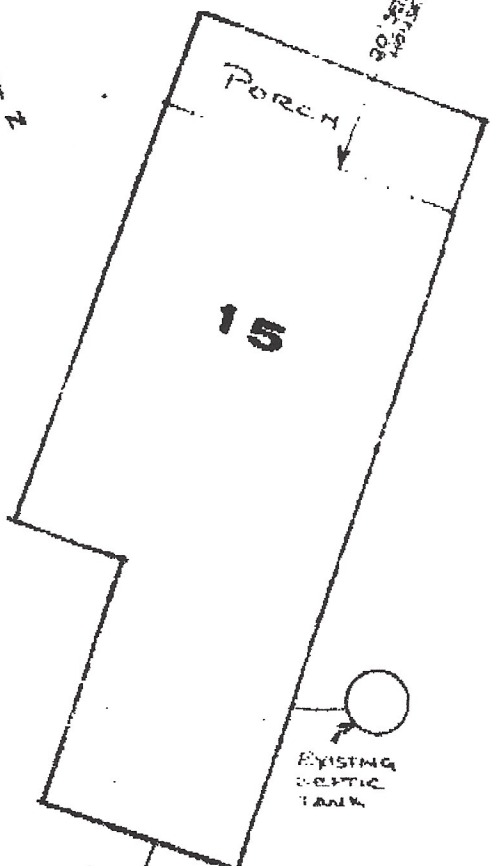

SYSTEM PLAN
1" = 10'

EDGE OF ROAD

WATER SERVICE

WATER SERVICE

WASTE SERVICE