

Commonwealth of Massachusetts

Title 5 Official Inspection Form

Subsurface Sewage Disposal System Form - Not for Voluntary Assessments

18 LAUREL PARK

Property Address

DAVID BAKER

Owner's Name

NORTHAMPTON MA 01060

City/Town

State

Zip Code


Date of Inspection

8/1/2014

D. System Information (cont.)

Sketch Of Sewage Disposal System: Provide a view of the sewage disposal system, including ties to at least two permanent reference landmarks or benchmarks. Locate all wells within 100 feet. Locate where public water supply enters the building. Check one of the boxes below:

- hand-sketch in the area below
- drawing attached separately

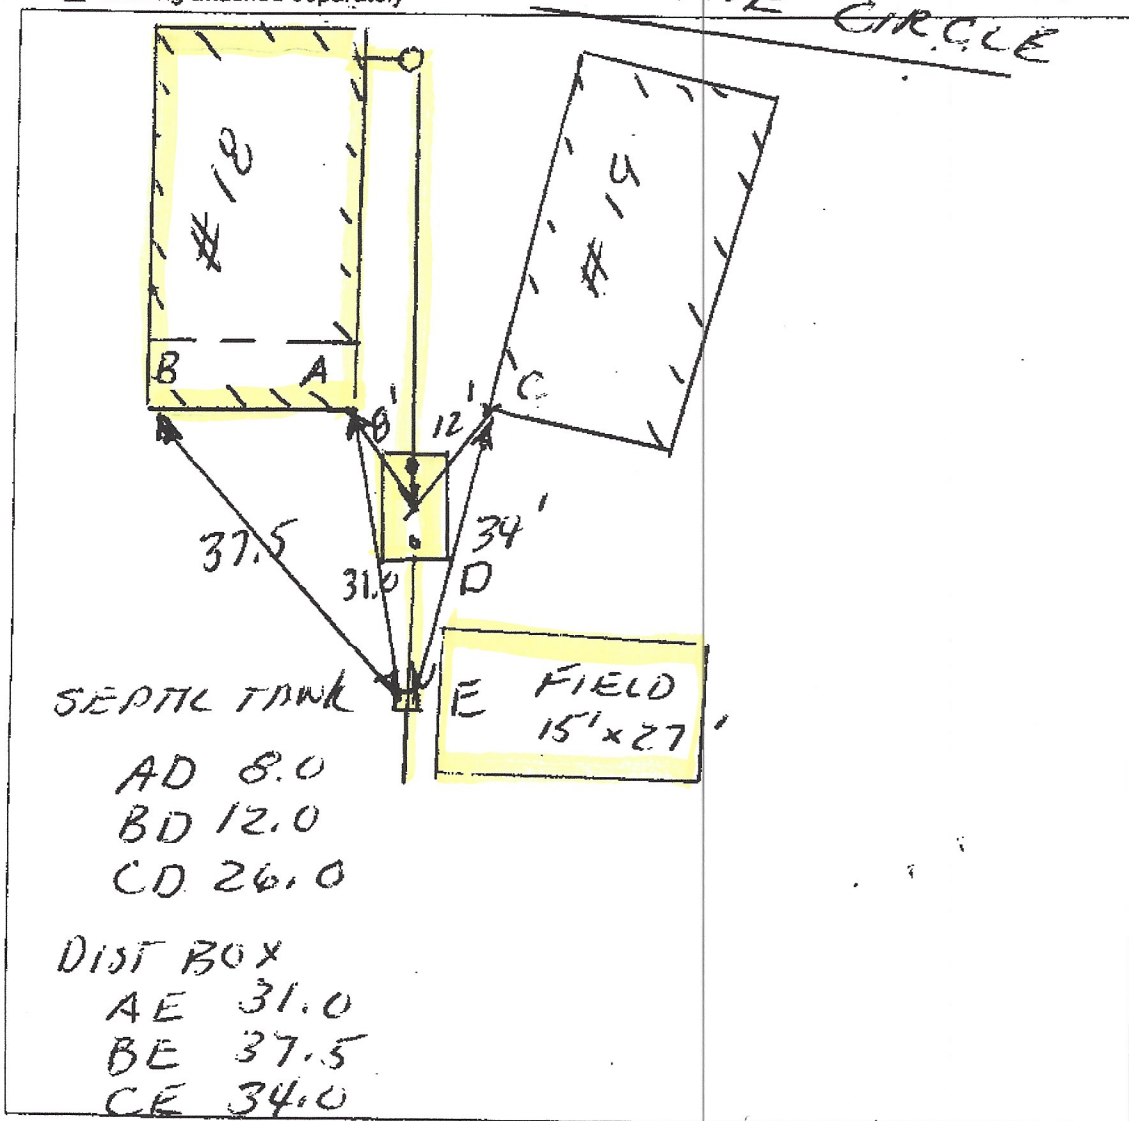

William Sierota - Engineer