

Page 10 of 11

SEPTIC DRAWING OF SYSTEM ONLY NO SCALE

OFFICIAL INSPECTION FORM - NOT FOR VOLUNTARY ASSESSMENTS SUBSURFACE SEWAGE DISPOSAL SYSTEM INSPECTION FORM


PART C SYSTEM INFORMATION (continued)

Property Address: 22 LAUREL PARK
AND THOMPSON MASS
Owner: DEBORAH WILLY
Date of Inspection: 06/19/15



SKETCH OF SEWAGE DISPOSAL SYSTEM

Provide a sketch of the sewage disposal system including ties to at least two permanent reference landmarks or benchmarks. Locate all wells within 100 feet. Locate where public water supply enters the building.

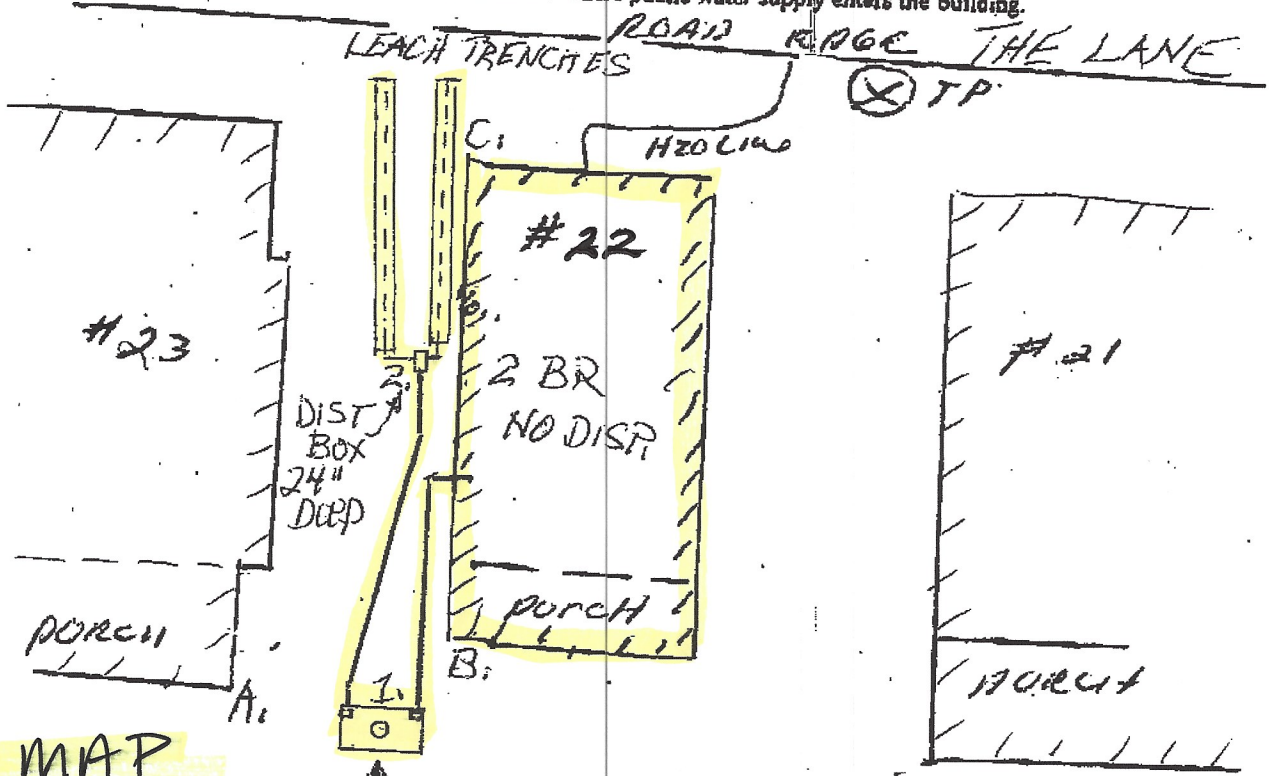

SEPTIC MAP
22
LAUREL PARK

2015

- A₁ - I₁ = 11'6"
- B₁ - I₁ = 10'
- B₁ - Z₁ = 23'8"
- C₁ - Z₁ = 19'

- 1 - TANK CENTER COVER
- 2 - DIST. BOX
- DIST. BOX 2.5' FROM HOUSE
- SEPTIC TANK 10'6" L X 5'8" W
- BAFFLE COVERS IN NORTH CORNERS OF SEPTIC TANK