


Septic Map - 2006

Unit # ~~22~~ 23

Called North

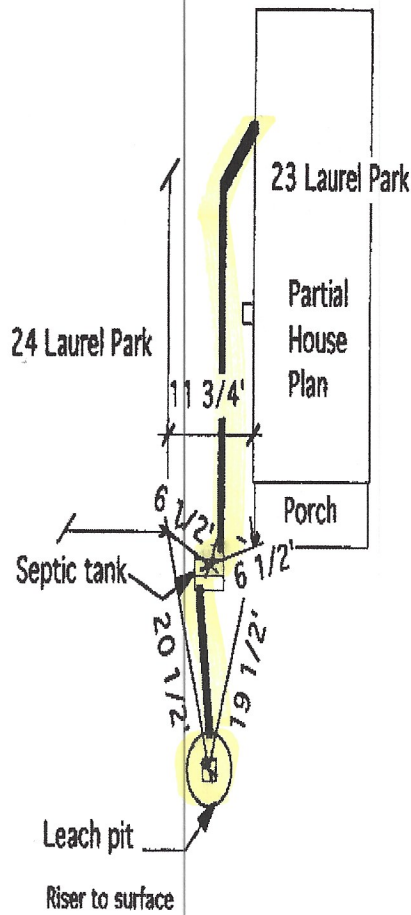

No known drinking water sources within 100' radius.

As-Built Drawing
Existing Septic System

Date:

6/2/06


Owner:

Bruce Kelley
23 Laurel Park
Northampton, MA 01060

Revision Date:

Scale: 1 : 20'

Except as Noted

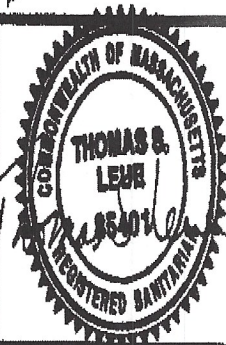

HOMESTEAD INC.
Thomas S. Leue R.S.

1664 Cape St.
Williamsburg, MA 01096
(413) 628-4533