


SEPTIC MAP
24
LAUREL PARK

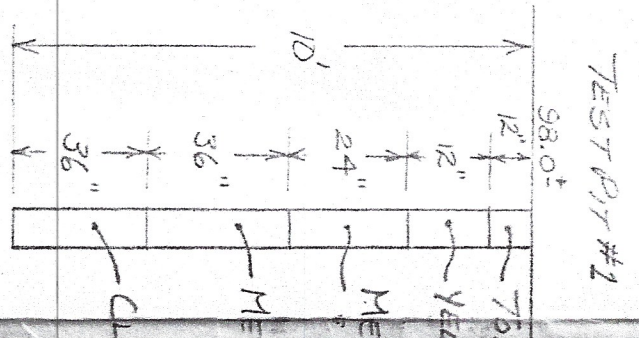

PERCOLATION

DATE: 8-6-

BY: J. A. G.

WITNESSES:

PERC. RATE