

SEPTIC MAP


27

LAUREL PARK

1991

Murder! I cleared this through Nancy.

George

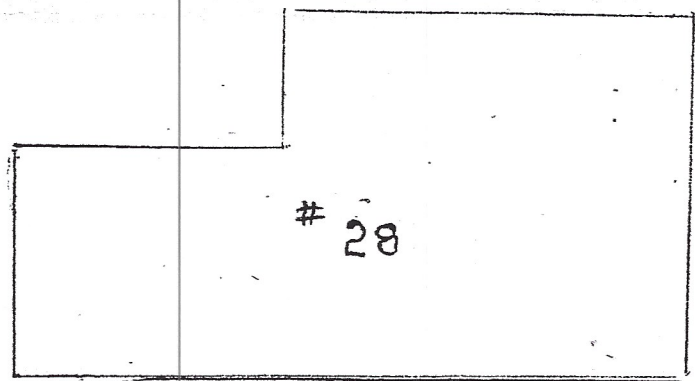

No Existing Systems within 40 Ft.

