

Unit # 28 Septic Map - 2003


LAUREL PARK William Sieruta - Engineer

OFFICIAL INSPECTION FORM - NOT FOR VOLUNTARY ASSESSMENTS  
SUBSURFACE SEWAGE DISPOSAL SYSTEM INSPECTION FORM  
PART C  
SYSTEM INFORMATION (continued)

Property Address: 28 LAUREL PARK  
NORTHAMPTON MA  
Owner: S ERAMPTON  
Date of Inspection: 8/19/03

SKETCH OF SEWAGE DISPOSAL SYSTEM

Provide a sketch of the sewage disposal system including ties to at least two permanent reference landmarks or benchmarks. Locate all wells within 100 feet. Locate where public water supply enters the building.

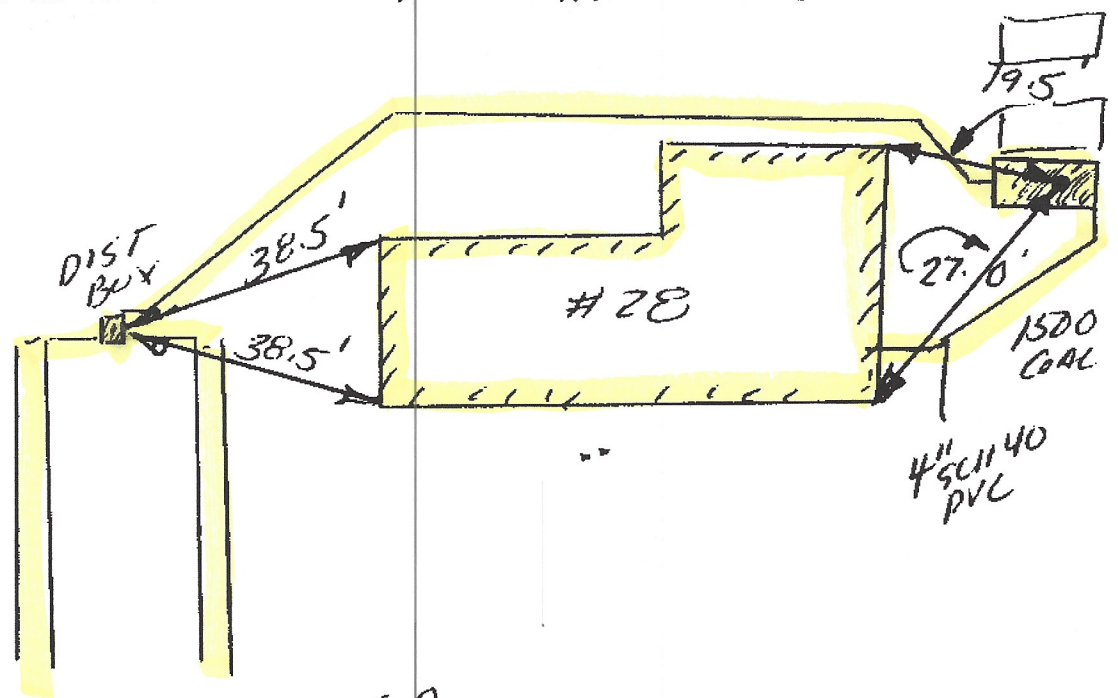

SYSTEM INSTALLED  
7/27/98

SEE ATTACHED PLANS

