


SEPTIC MAP

30

LAUREL PARK

1997

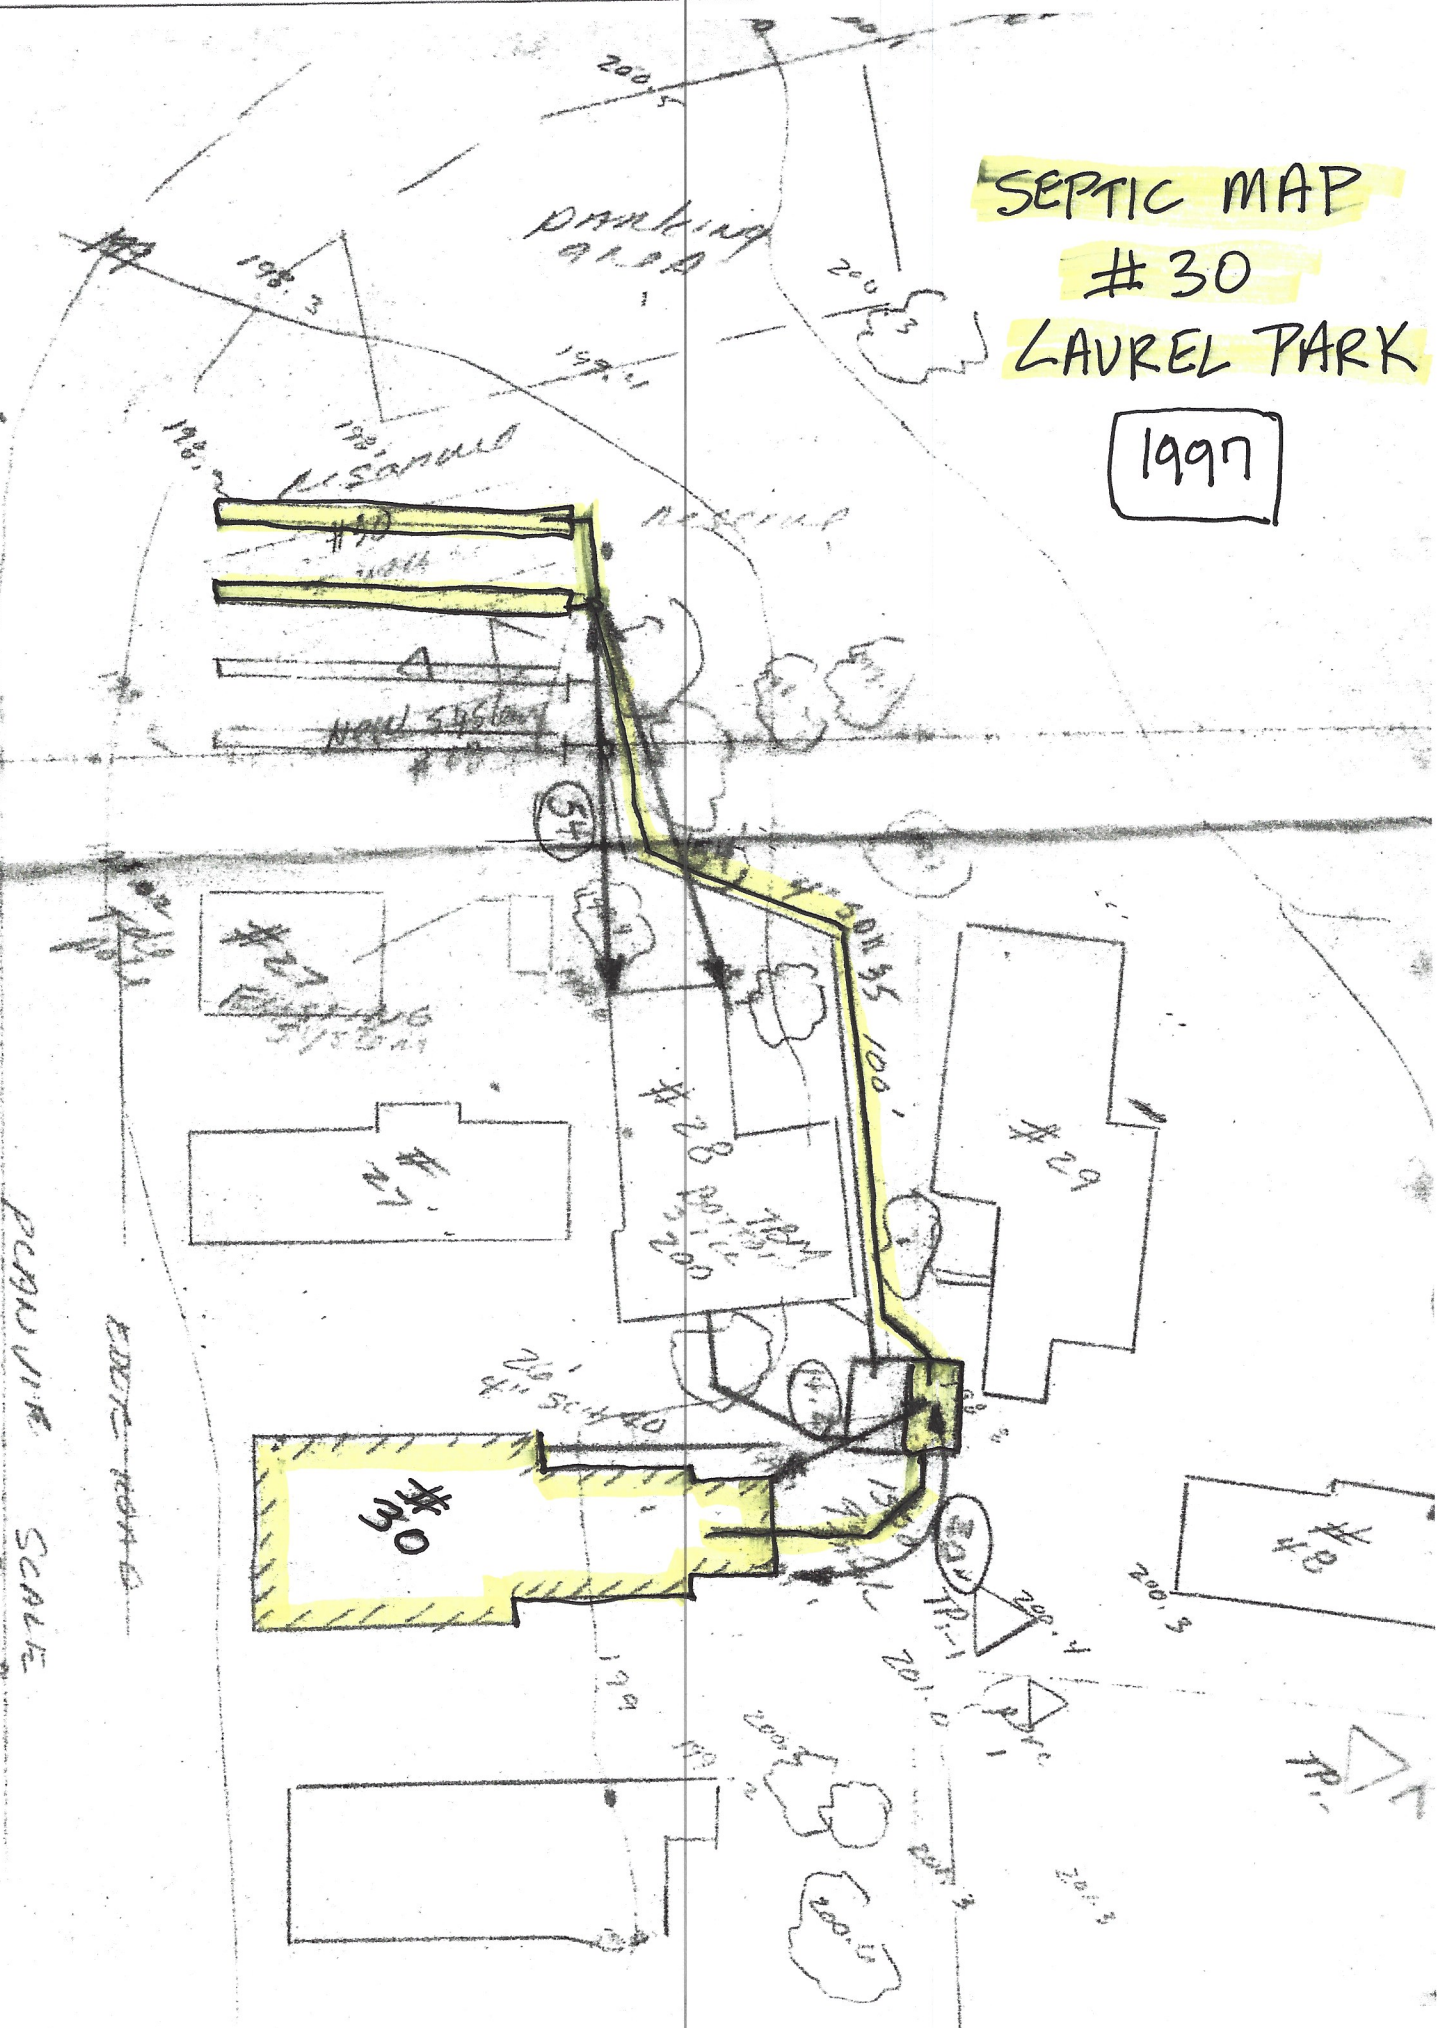

PERMITS SCALE
1" = 20'

EDGE ROAD