


SEPTIC MAP

#31

LAUREL PARK

2005

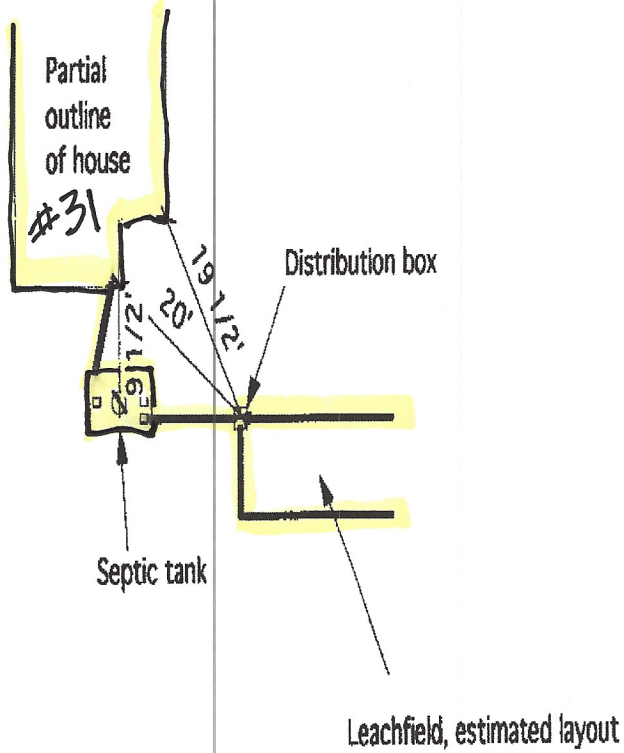


Note: No known drinking water sources within 100 foot radius.



COMMENTS:

Recommend pumping on a 3 to 5 year schedule. Also, a copy of this plan posted in the basement/utility area would keep this information accessible in future years for maintenance.

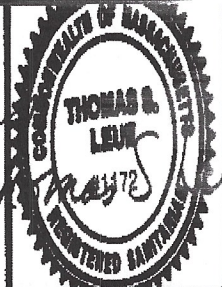As-Built Drawing Existing Septic System	Date: 5/19/05	Owner: Charles DeMauro 31 Laurel Park Northampton, MA 01060		HOMESTEAD INC. Thomas S. Leue R.S. Williamsburg, MA 01096 (413) 628-4533
	Scale: 1 : 20' Except as Noted			