


Baker ST.



SEPTIC MAP
34
LAUREL PARK

2019

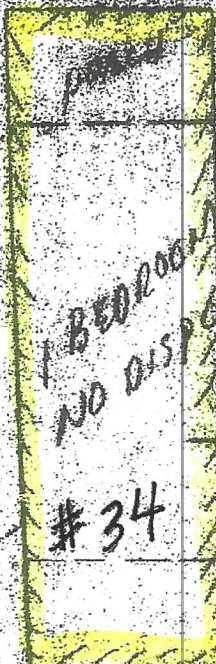

34

1 BEDROOM
NO DISPOSAL

4" SCH 40
EQUIV. VOLUME
TBM

SILL
RETURN
2.00'


4" SCH 40
PVL

10'

1500 GAL
2 COMP
TANK

EXISTING
SEPTIC
TANK

4" SCH 35
1502 PVL

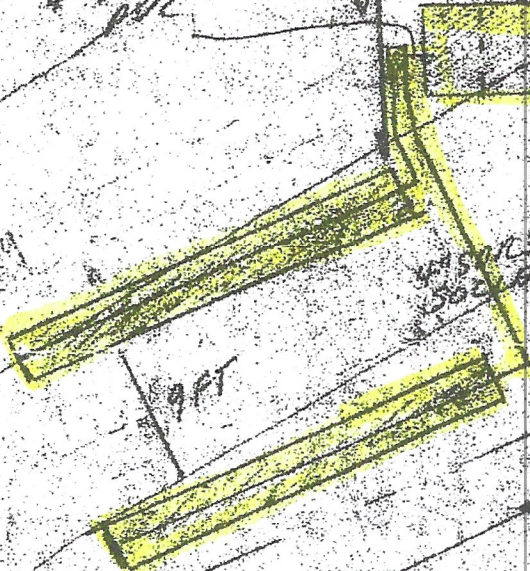

9 FT

The Lane

EDGE ROAD

22'

PLAN VIEW SCALE 1" = 10 FT