

Commonwealth of Massachusetts

Title 5 Official Inspection Form

Subsurface Sewage Disposal System Form - Not for Voluntary Assessments

35 LAUREL PARK

Property Address

LYNDA HOLLIDAY

Owner's Name

NORTHAMPTON

City/Town

MA.
State

01060
Zip Code


May 12, 2015
Date of Inspection

Owner information is required for every page.

D. System Information (cont.)

Sketch Of Sewage Disposal System: Provide a view of the sewage disposal system, including ties to at least two permanent reference landmarks or benchmarks. Locate all wells within 100 feet. Locate where public water supply enters the building. Check one of the boxes below:

- hand-sketch in the area below
- drawing attached separately

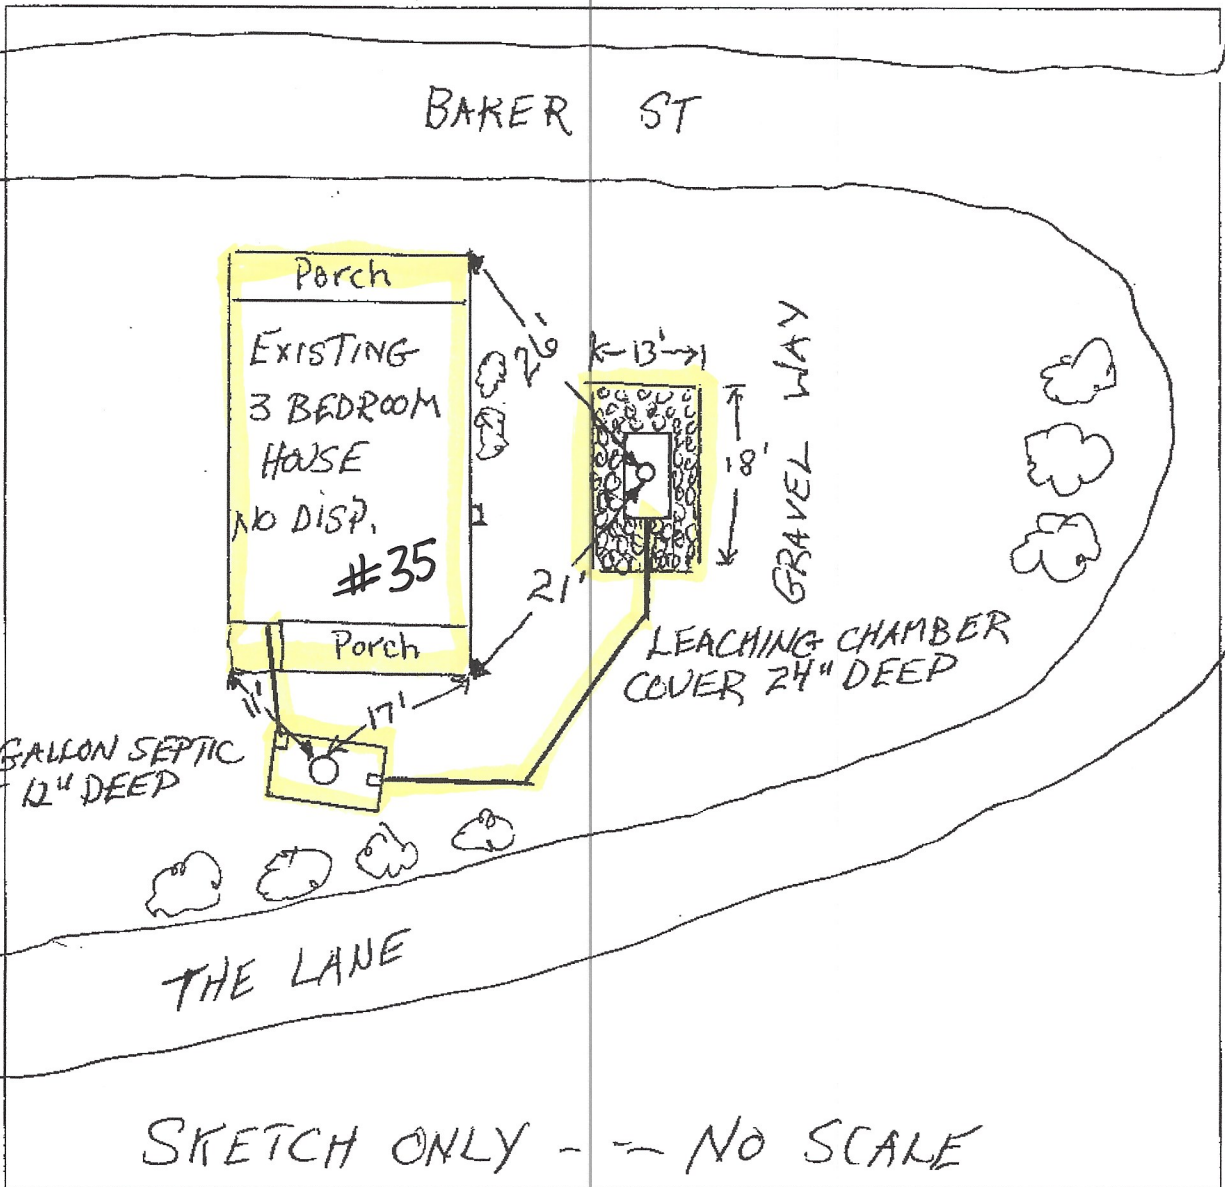

SCOTT DR

SKETCH ONLY - NO SCALE