

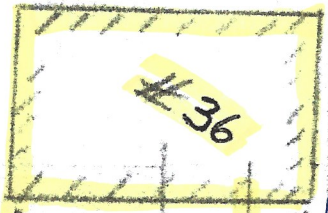
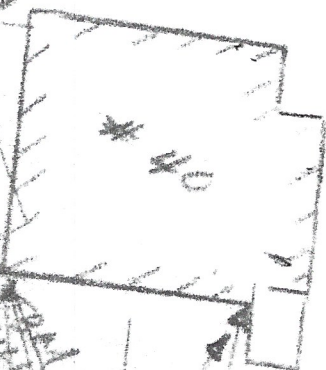


1/3
11/11/11
200'

ROAD

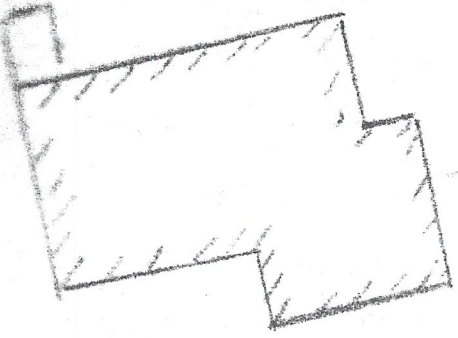

177.4
178.4
179.4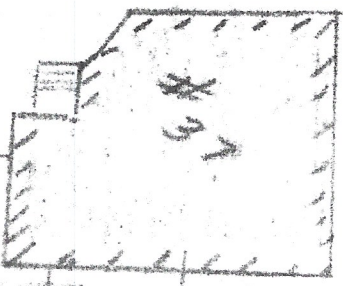
SEPTIC SYSTEM

MAP # 36

LAUREL PARK



LEACH

NO WELLS
WITH IN 200'

