
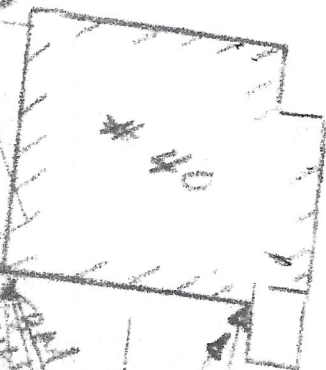
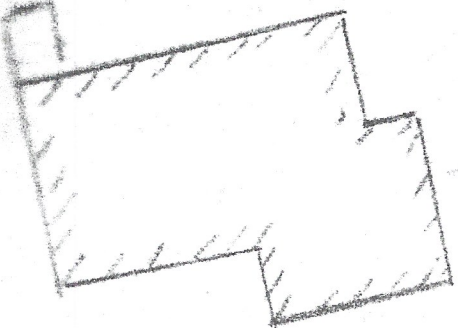
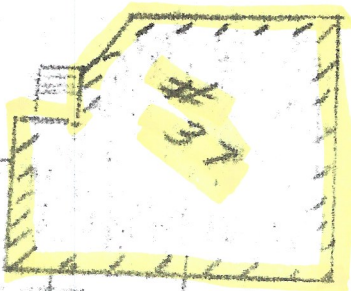


ROAD

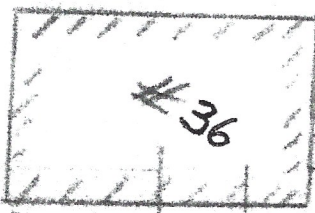

SEPTIC SYSTEM
MAP # 37

LAUREL PARK

2004

1/5
1/5
200'

NO WALLS
WITH IN 200'

TRAIL SIDE HOUSE
FILLED PIT
New 1500 GALLON TRUCK
& COME

LAUREL PARK AREA

1100
EVEN

TRAIL SIDE HOUSE



1700
1700
