


COMMENTS:

Recommend pumping on a 3 to 5 year schedule. Also, a copy of this plan posted in the basement/utility area would keep this information accessible in future years for maintenance.

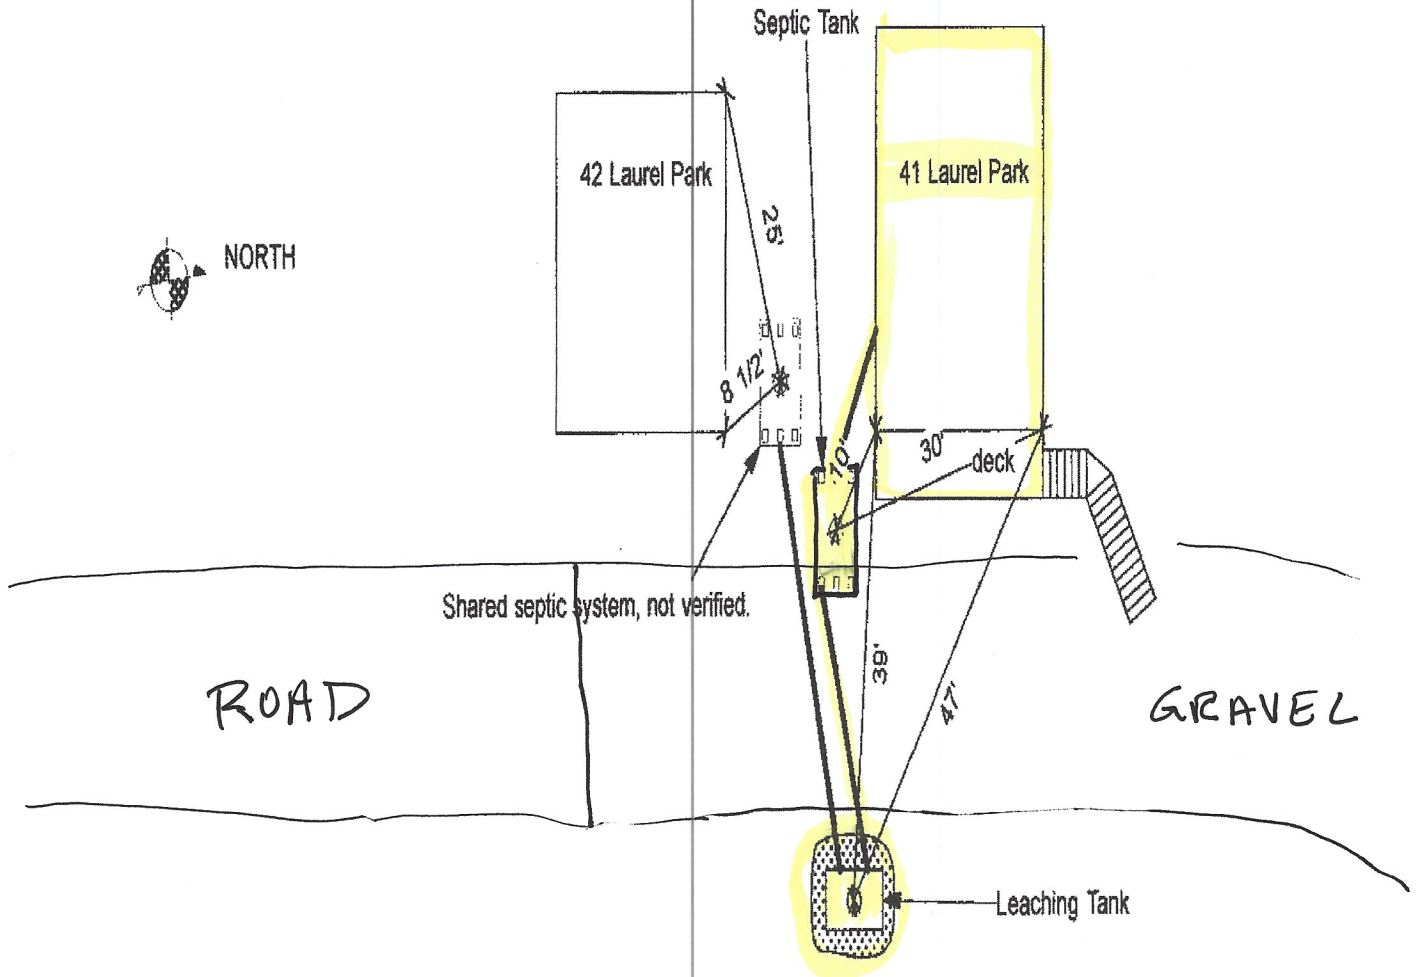

Note: No known drinking water sources within 100 foot radius.

**SHARED SEPTIC MAP
LAUREL PARK UNITS # 41 and # 42**

As-Built Drawing Existing Septic System	Date: 9/8/2015	Owner: Bud Stockwell 41 laurel Park Northampton, MA 01060		HOMESTEAD INC. Thomas S. Leue R.S. 1664 Cape St. Williamsburg, MA 01096 [413] 628-4533
	Scale: 1 : 20' Except as Noted			

SHARED SEPTIC SYSTEM MAP

LAUREL PARK UNITS # 42 and # 41



Commonwealth of Massachusetts

Title 5 Official Inspection Form

Subsurface Sewage Disposal System Form - Not for Voluntary Assessments

42 LAUREL PARK

Property Address

NORMA ROCHE

Owner's Name

NORTHAMPTON MA 01060 4/26/2016

City/Town

State

Zip Code


Date of Inspection

Owner information is required for every page.

D. System Information (cont.)

Sketch Of Sewage Disposal System: Provide a view of the sewage disposal system, including ties to at least two permanent reference landmarks or benchmarks. Locate all wells within 100 feet. Locate where public water supply enters the building. Check one of the boxes below:

- hand-sketch in the area below
- drawing attached separately

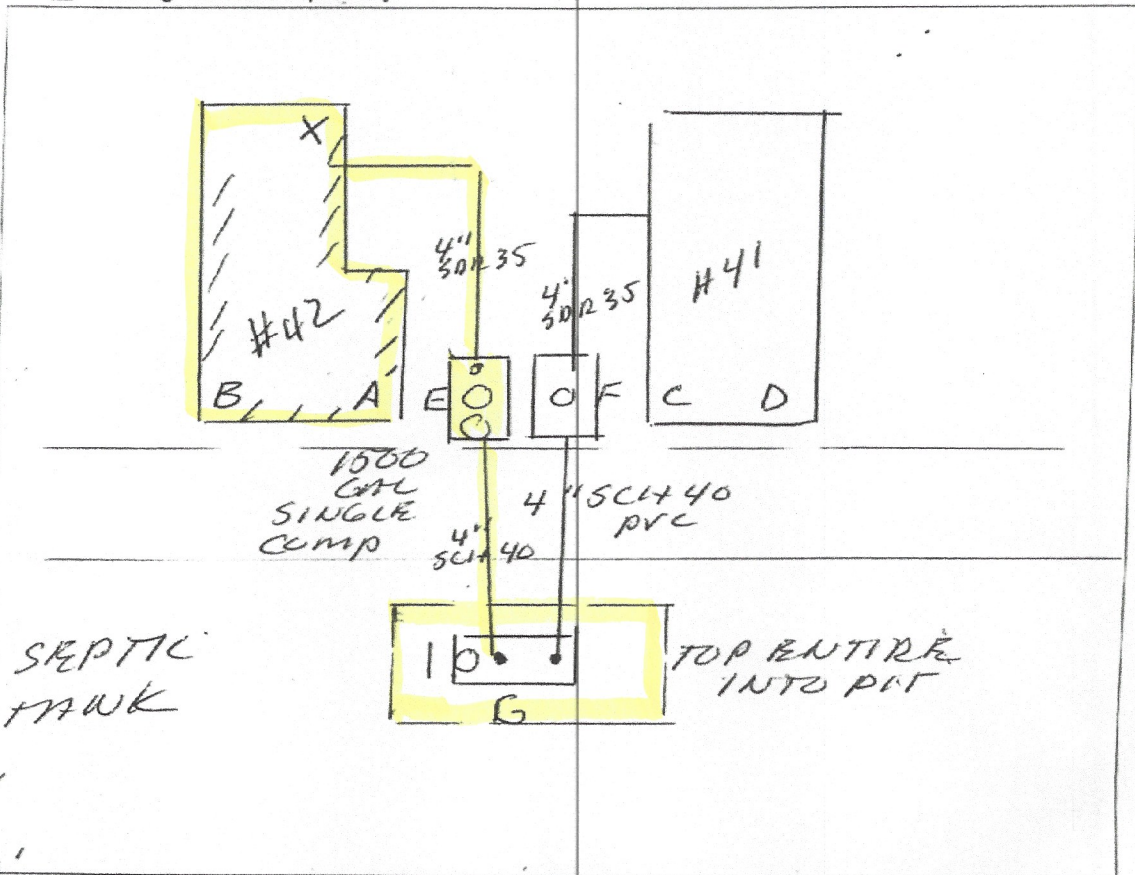

#42
TIES TO SEPTIC
SEPTIC TANK
E MH
AE 8.0'
BE 30'
XE 25.0'

LEACH PIT MH

#42 AG 38' #41 CG 39'
BG 50' DG 47'