



SCOTT AVE

SEPTIC MAP # 43 LAUREL PARK

NO WELLS WITHIN 200'

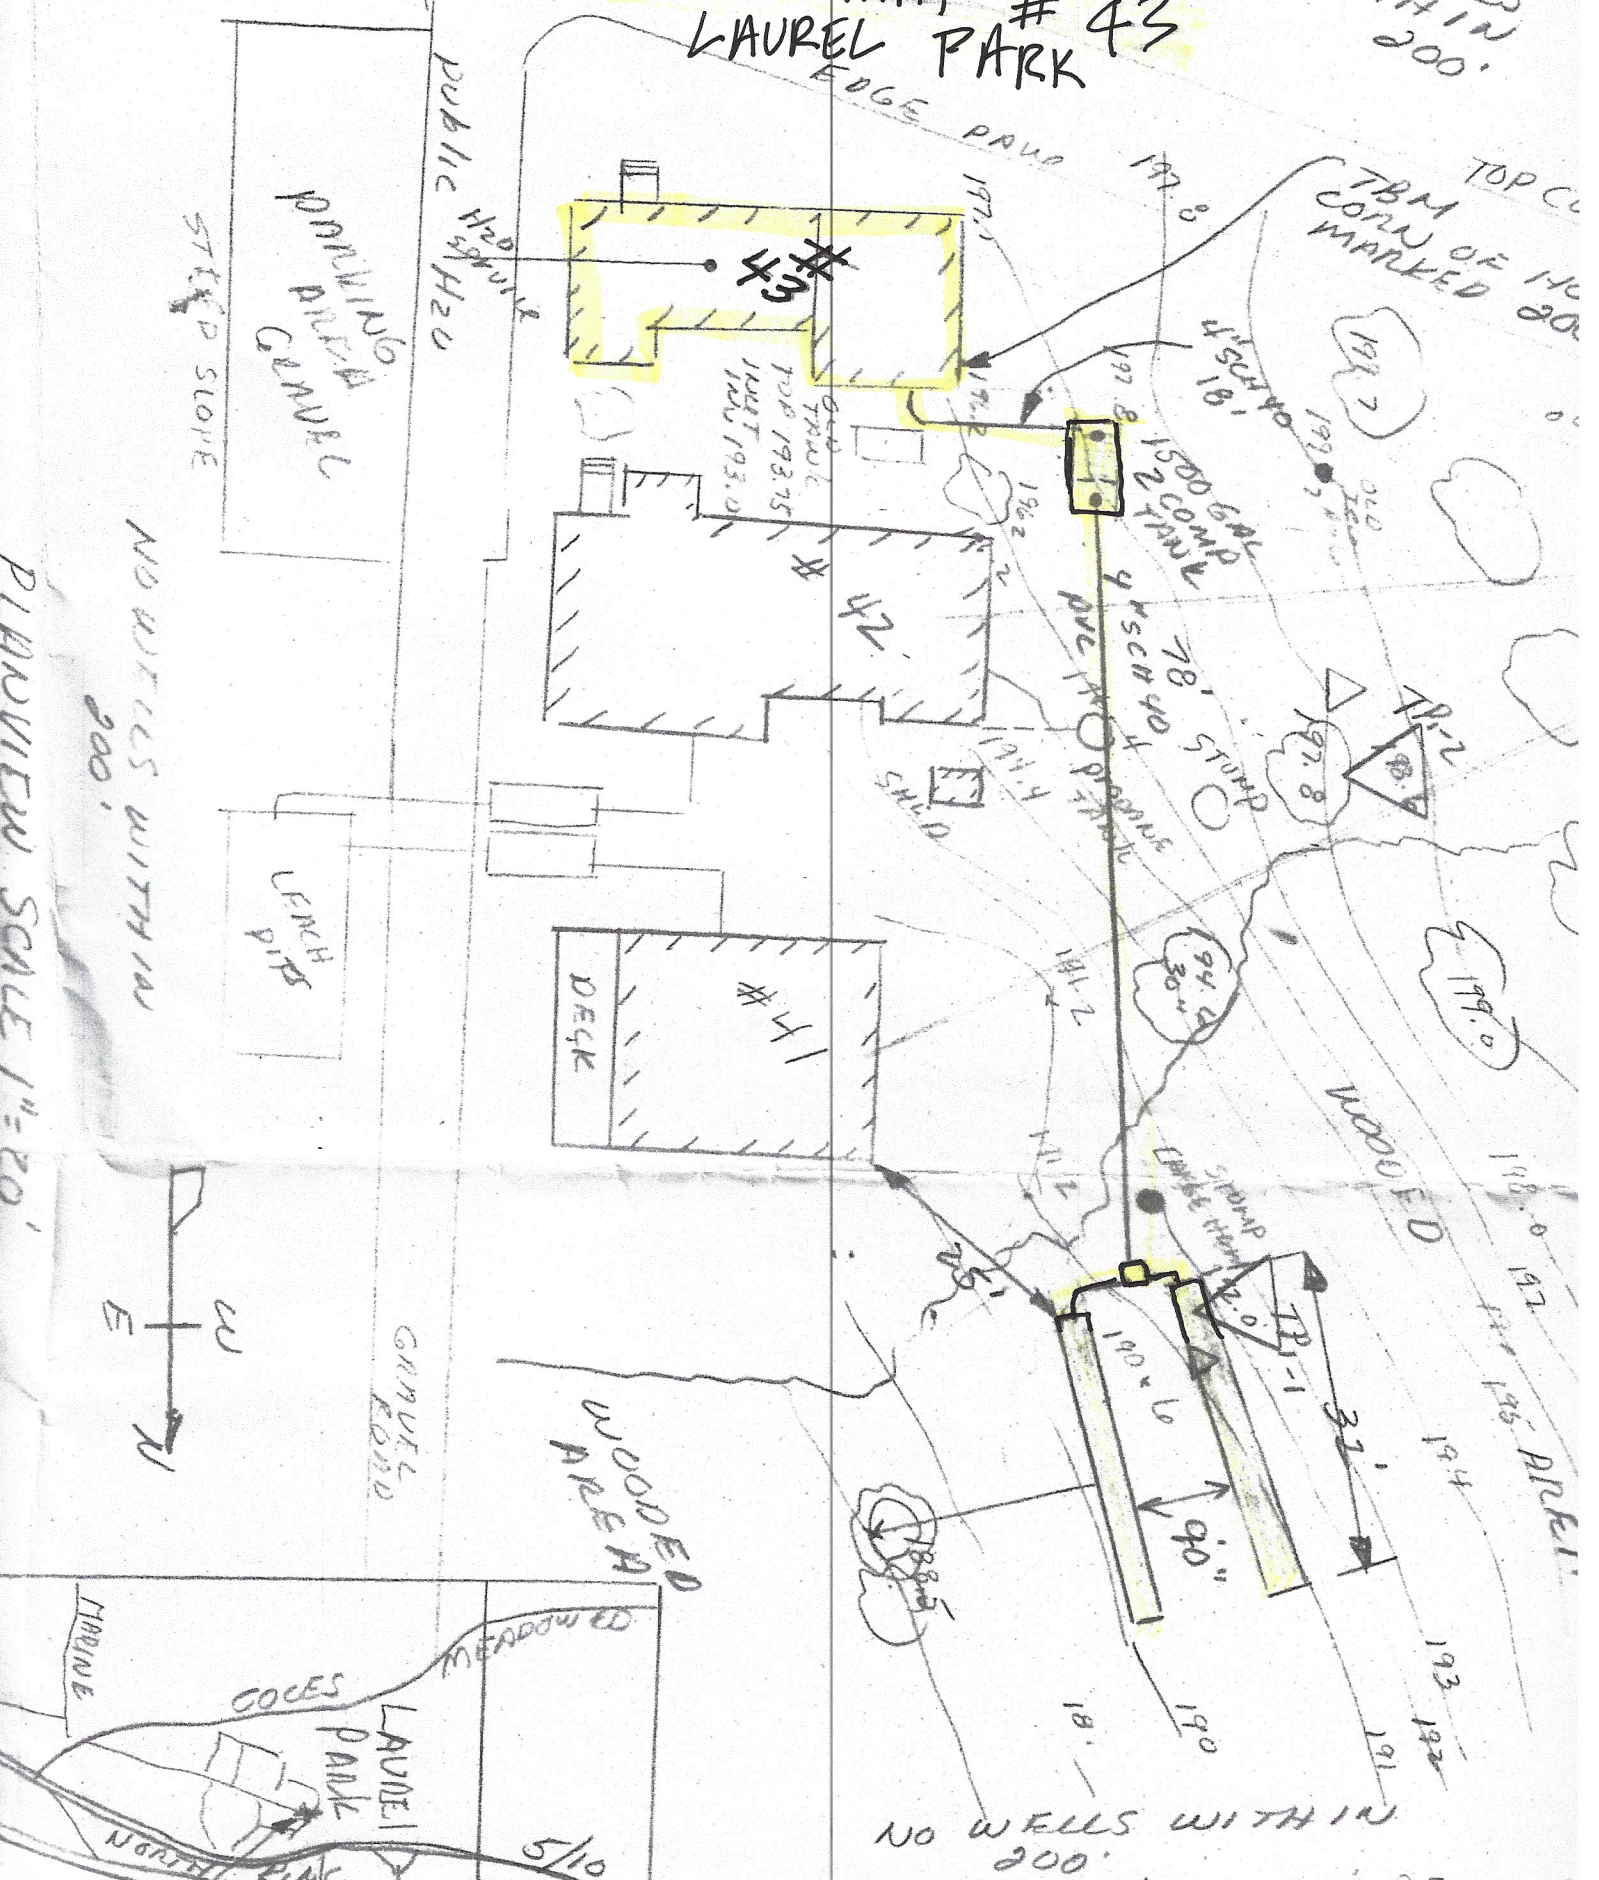

PLANVIEW SCALE 1"=20'

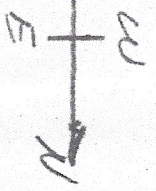

NO WELLS WITHIN 200'

