


SEPTIC SYSTEM MAP LAUREL PARK UNIT # 46

North

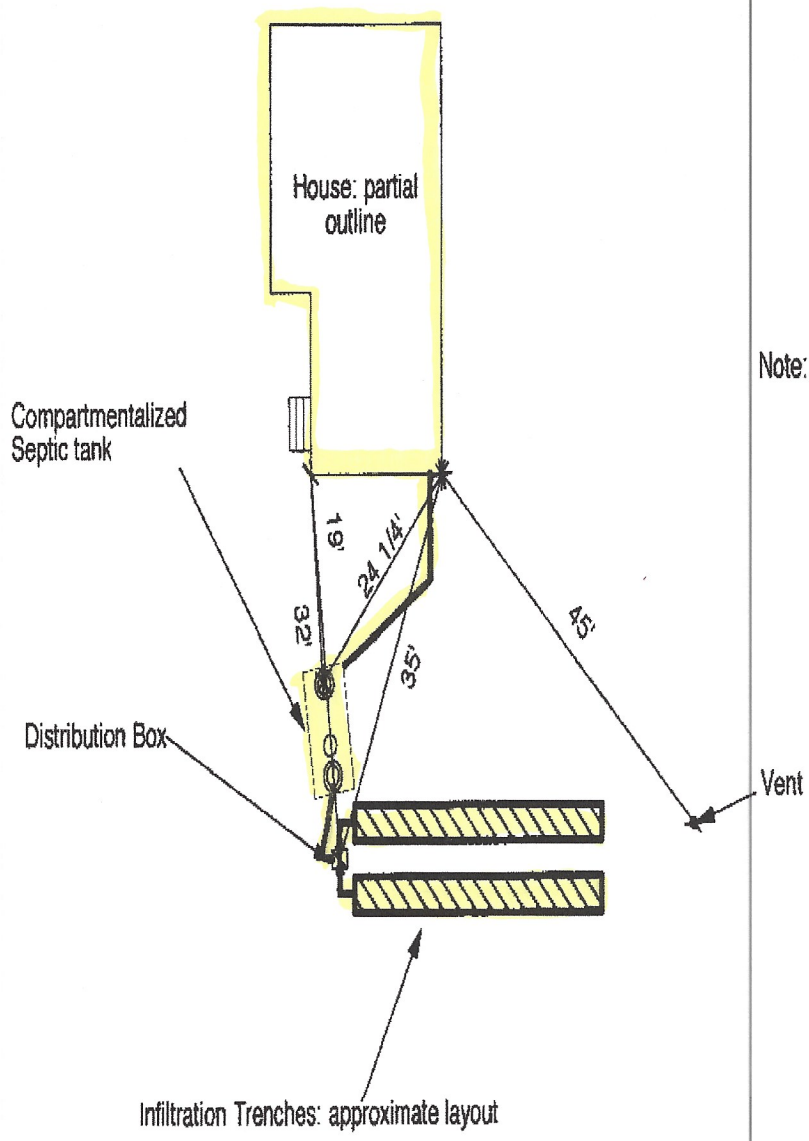

Note: no known drinking water sources within 100 foot radius.

COMMENTS:

Recommend pumping on a 3 to 5 year schedule. Also, a copy of this plan posted in the basement/utility area would keep this information accessible in future years for maintenance.

As-Built Drawing Existing Septic System	Date: 9/16/2014	Owner: Laurie Scanton & John Tischler 46 Laurel Park Northampton, MA 01060		HOMESTEAD INC. Thomas S. Leue R.S. 1664 Cape St. Williamsburg, MA 01096 [413] 628-4533
	Scale: 1 : 20' Except as Noted	Revision Date:		