


# L.P. Unit # 48 - Septic System (Map)


DOES NOT EXIST →

CESSPOOL

Note: no known drinking water sources within 100 foot radius.

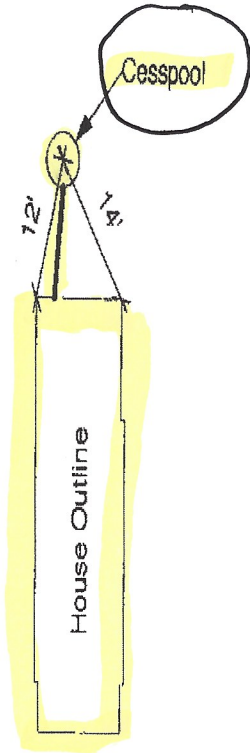

NORTH

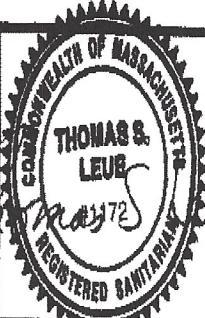As-Built Drawing Existing Septic System	Date: 9/26/2013	Owner: Dave George 48 Laurel Park Northampton, MA 01060		HOMESTEAD INC. Thomas S. Leue R.S.  1664 Cape St. Williamsburg, MA 01096 (413) 628-4533
Scale: 1 : 20' Except as Noted	Revision Date:			