

Unit # 49 - Septic System Map

William Sieruta - Engineer


OFFICIAL INSPECTION FORM - NOT FOR VOLUNTARY ASSESSMENTS SUBSURFACE SEWAGE DISPOSAL SYSTEM INSPECTION FORM PART C SYSTEM INFORMATION (continued)

Property Address: 49 CANTAL PARK
NORTHAMPTON MA
Owner: K BREWSTER
Date of Inspection: 6/16/06

SKETCH OF SEWAGE DISPOSAL SYSTEM
Provide a sketch of the sewage disposal system including ties to at least two permanent reference landmarks or benchmarks. Locate all wells within 100 feet. Locate where public water supply enters the building.

See ATTACHED plan

OS #

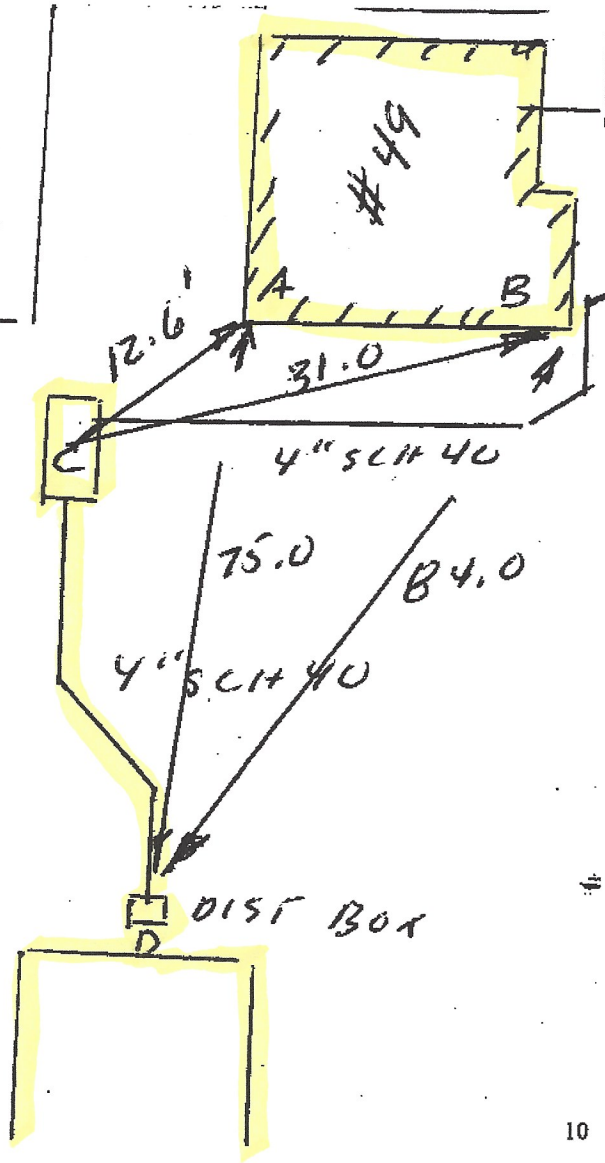

CURM OUT ACCESS

SEPTIC TANK

AC 12.6'
BC 31.0'

DIST BOX

AD 75.0'
BD 84.0'