

# Septic System Map # 53 Laurel Park

at 53 Laurel Park


Northampton, Ma.

Inspection Date 12/13/81

Drawing Not to Scale

Leach Pit 4' Diameter x 5' Deep

500 Gallon Septic Tank

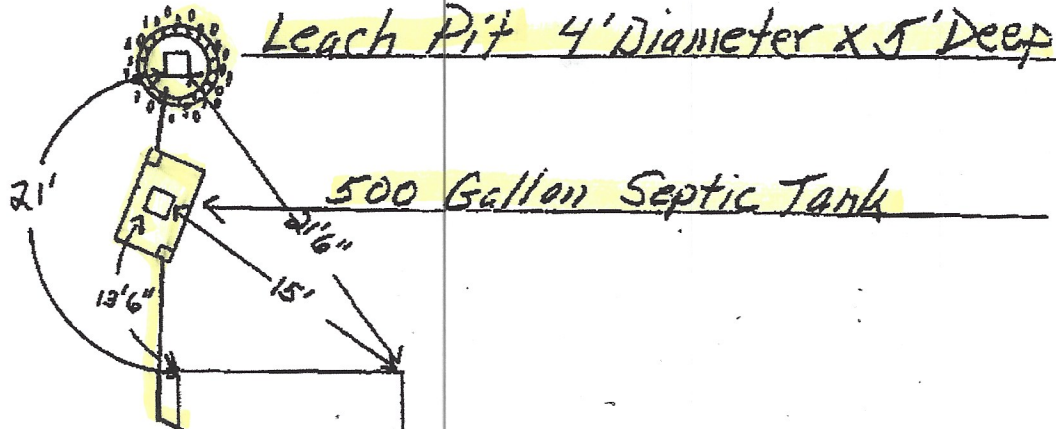

Water Main Shutoff

2-Bedroom Dwelling

# 53

Parking

