
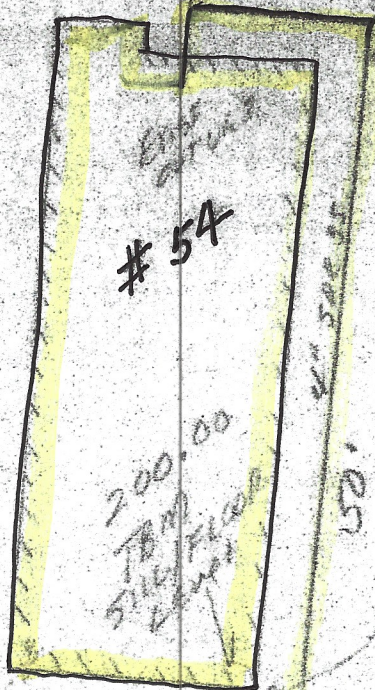


SEPTIC MAP

54

LAUREL PARK

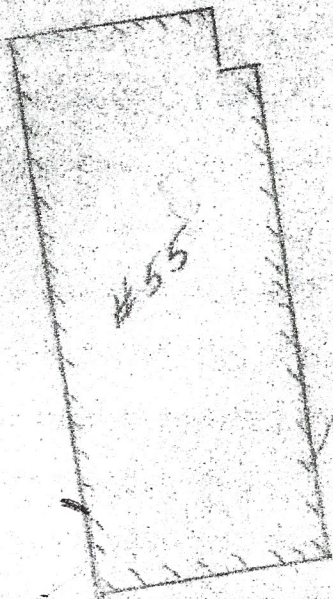

PARKING AREA