


Unit # 56 - Septic Map

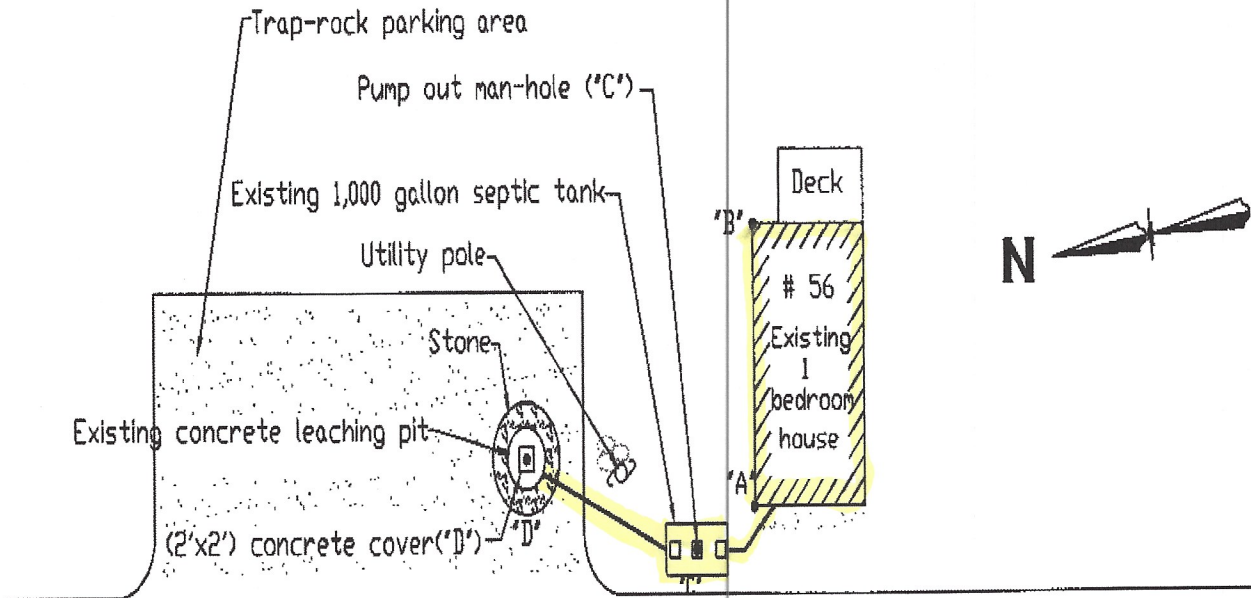

56 LAUREL PARK - NORTHAMPTON, MASSACHUSETTS

AS-BUILT DIMENSIONS

"A" to "C" = 8'-3"

"B" to "C" = 27'-2"

"A" to "D" = 30'-6"

"B" to "D" = 35'-6"

TITLE-5

AS-BUILT SEWAGE DISPOSAL PLAN

SITE:

56 Laurel Park

Northampton, Massachusetts

Owner's name:

Mary E. Griffin

154 Crescent Street

Northampton, MA. 01060

Tel: (413) 584-0563

July 22, 2013