

Commonwealth of Massachusetts

Title 5 Official Inspection Form

Subsurface Sewage Disposal System Form - Not for Voluntary Assessments

57 LAUREL PARK

Property Address

ERWIN T. WESTON

Owner's Name

NORTHAMPTON

City/Town

MA.
State

01060
Zip Code

10/22/15
Date of Inspection


Owner information is required for every page.

D. System Information (cont.)

Sketch Of Sewage Disposal System: Provide a view of the sewage disposal system, including ties to at least two permanent reference landmarks or benchmarks. Locate all wells within 100 feet. Locate where public water supply enters the building. Check one of the boxes below:

- hand-sketch in the area below
- drawing attached separately

Sketch Not to Scale

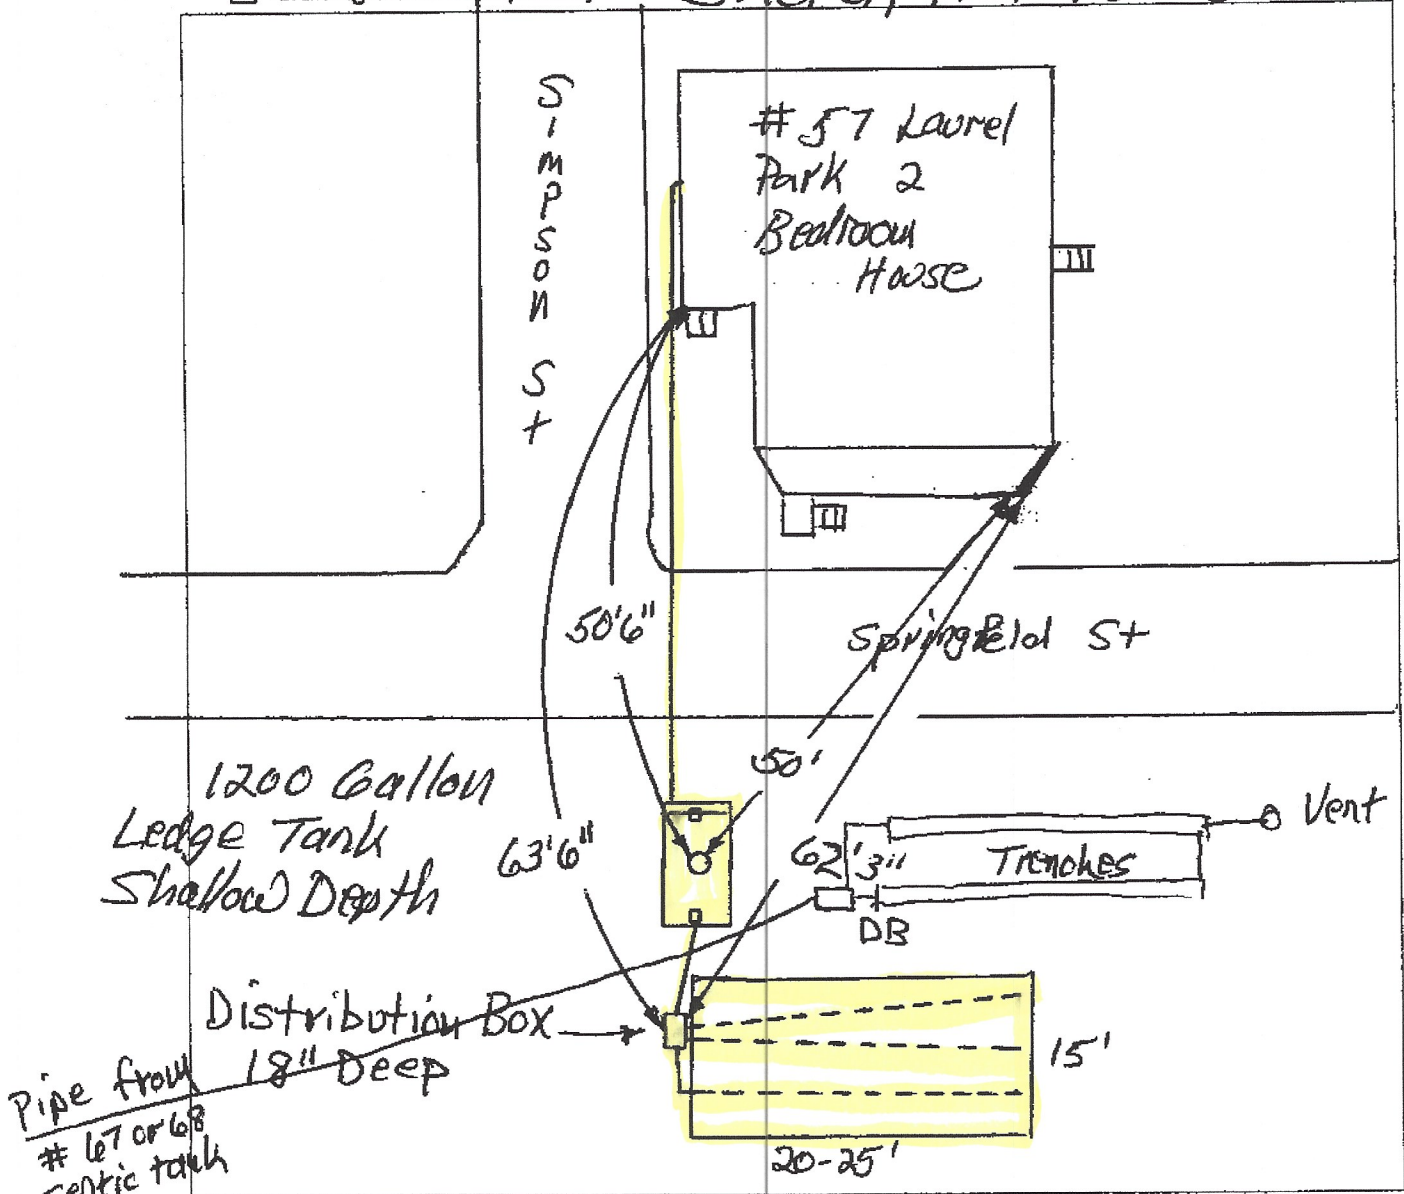

No Changes to Hand Sketch Except D-Box Ties