


APPROVED

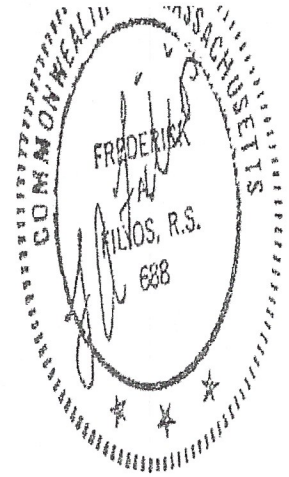

6/16/96
Jhu

BURNING BUSH
TREES CAUSING ROT
INFILTRATION INTO
OUTLET BAFFLE

SIMPSON DRIVE



#60 LAUREL PARK
NORTHAMPTON, MA
AS BUILT

B.M.
MECO
POLE #3

100'

TEST
PIT

99'

NO VEHICLE PARKING
IN THIS AREA

LEACH PIT
12.5' X 7' X 3'

98'

97'

APPROX. WATER LINE

PROPOSED PARKING

BARRIER
WAS NOT INSTALLED

SEPTIC MAP

#60

LAUREL PARK

2017