


Unit # 62 - Septic Map

LAUREL PARK - 2002

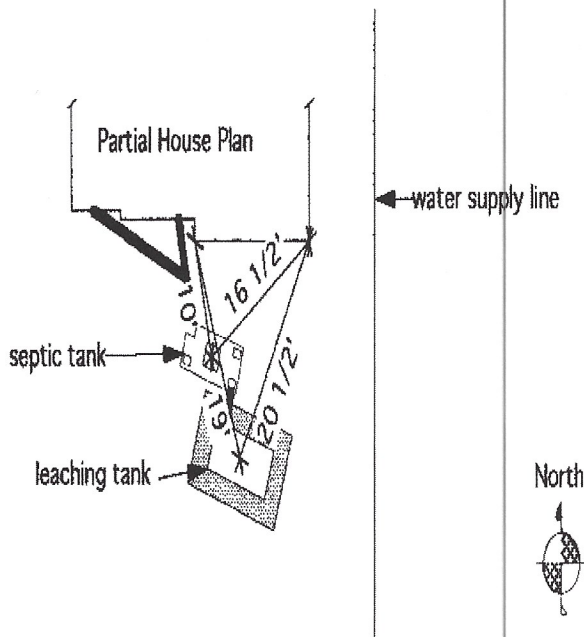

<p>As-Built Drawing Existing Septic System</p>	<p>Date: 3/20/02</p>	<p>Owner: Dan Drolette 62 Laurel Park Northampton, MA 01060</p>		<p>HOMESTEAD INC. Thomas S. Leue R.S. 1664 Cape St. Williamsburg, MA 01096 {413} 628-4533</p>
<p>Scale: 1 : 20' Except as Noted</p>	<p>Revision Date:</p>			