


Unit # 64 - Septic Map.

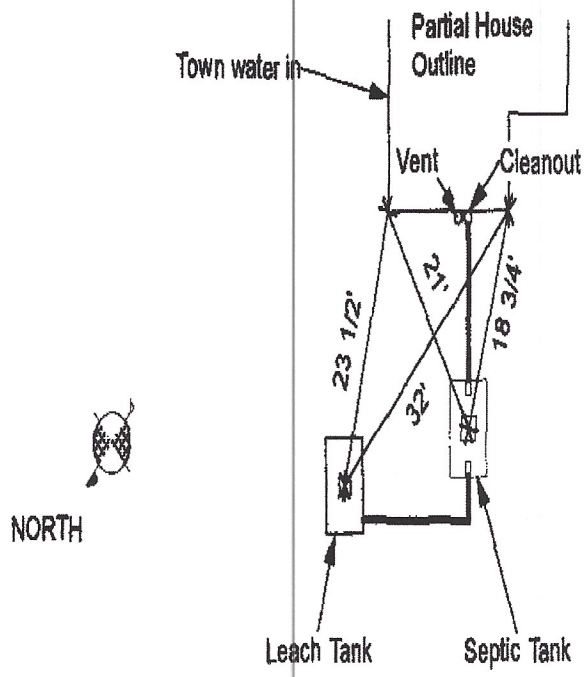

Note: No known drinking water sources within 100 foot radius.

As-Built Drawing Existing Septic System	Date: 4/17/2018	Owner: Ann Waller		HOMESTEAD INC. Thomas S. Leue R.S.
Scale: 1 : 20' Except as Noted	Revision Date:	64 Laurel Park Northampton MA 01060		1664 Cape St. Williamsburg, MA 01096 (413) 628-4533