


SEPTIC MAP
#65 and #66
LAUREL PARK

1988 Original
Blueprint
(Shared septic)

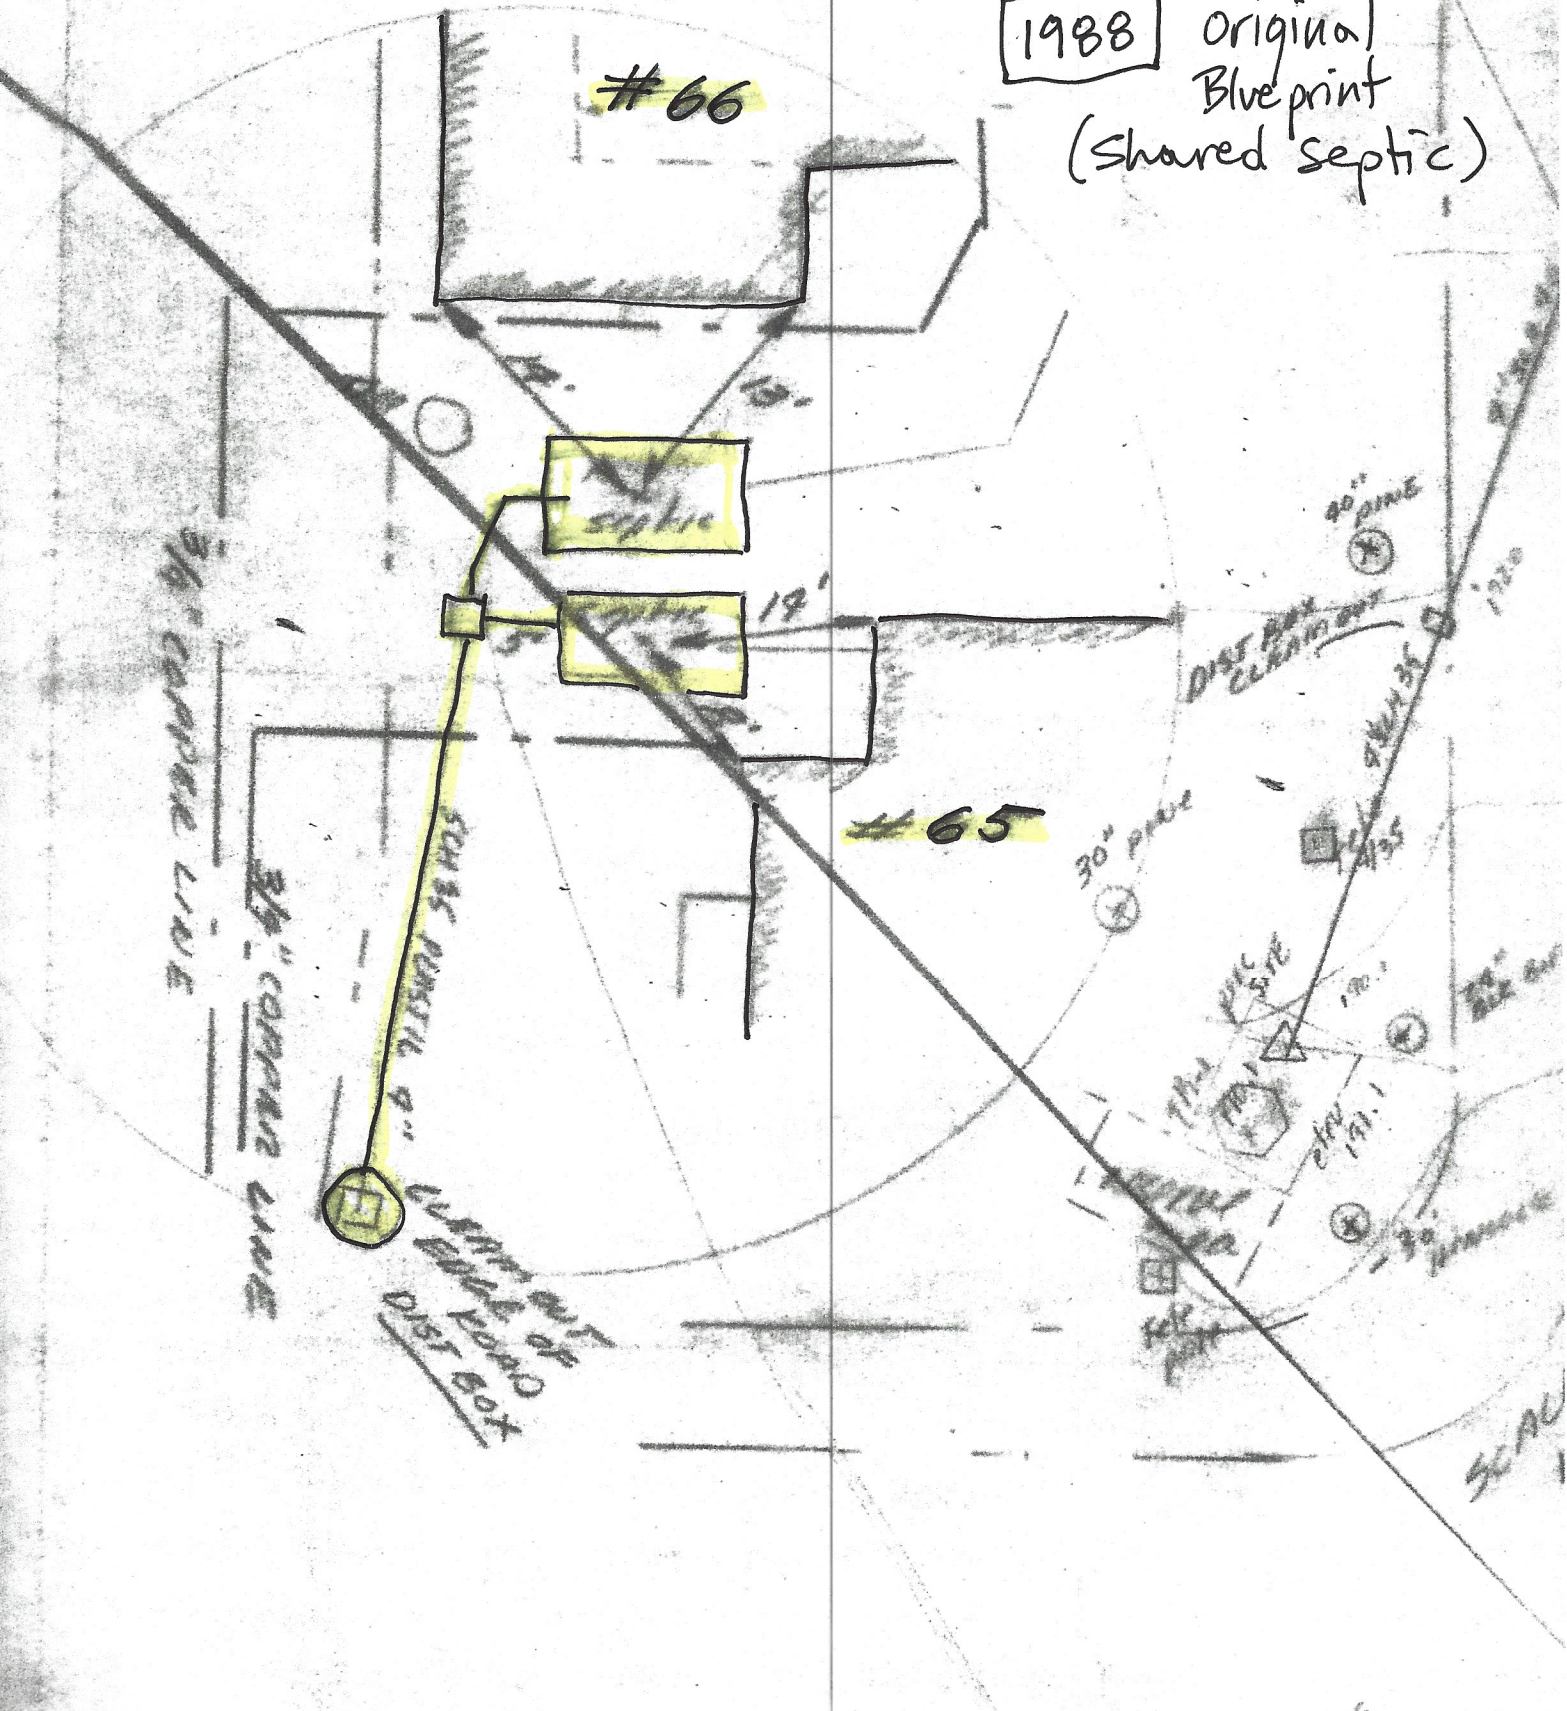


Note: No known drinking water sources within 100' radius.

Unit # 66 and # 65
 Septic Map.
 (shared septic)

Note: additional sewage flows reported to enter these tanks from unknown locations and to unknown connection points.

Leach tanks, approximate locations

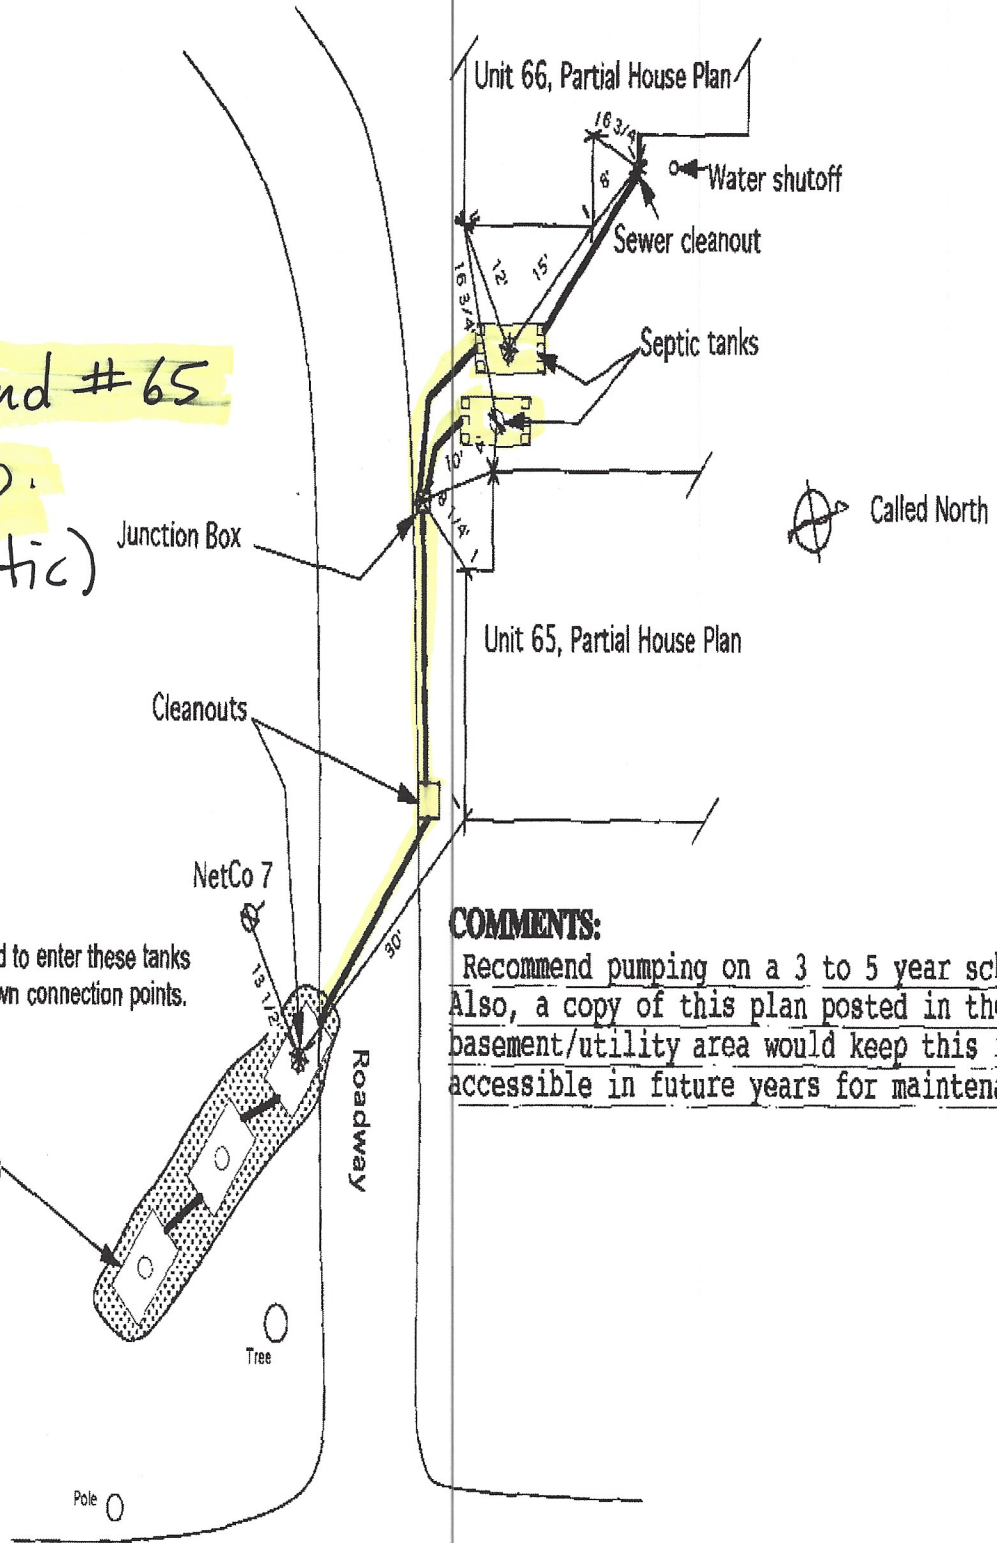

COMMENTS:

Recommend pumping on a 3 to 5 year schedule.
 Also, a copy of this plan posted in the basement/utility area would keep this information accessible in future years for maintenance.

As-Built Drawing Existing Septic System	Date: 5/17/2018	Owner: Bill Lashway		HOMESTEAD INC. Thomas S. Leue R.S. 1664 Cape St. Williamsburg, MA 01096 [413] 628-4533
Scale: 1 : 20' Except as Noted	Revision Date:	66 Laurel Park Northampton MA 01060		