


LAUREL PARK  
SITE OWNER

SEPTIC MAP  
# 68  
LAUREL PARK  
1996

WRITTEN BY  
BOB  
LIMITED  
PARTNER

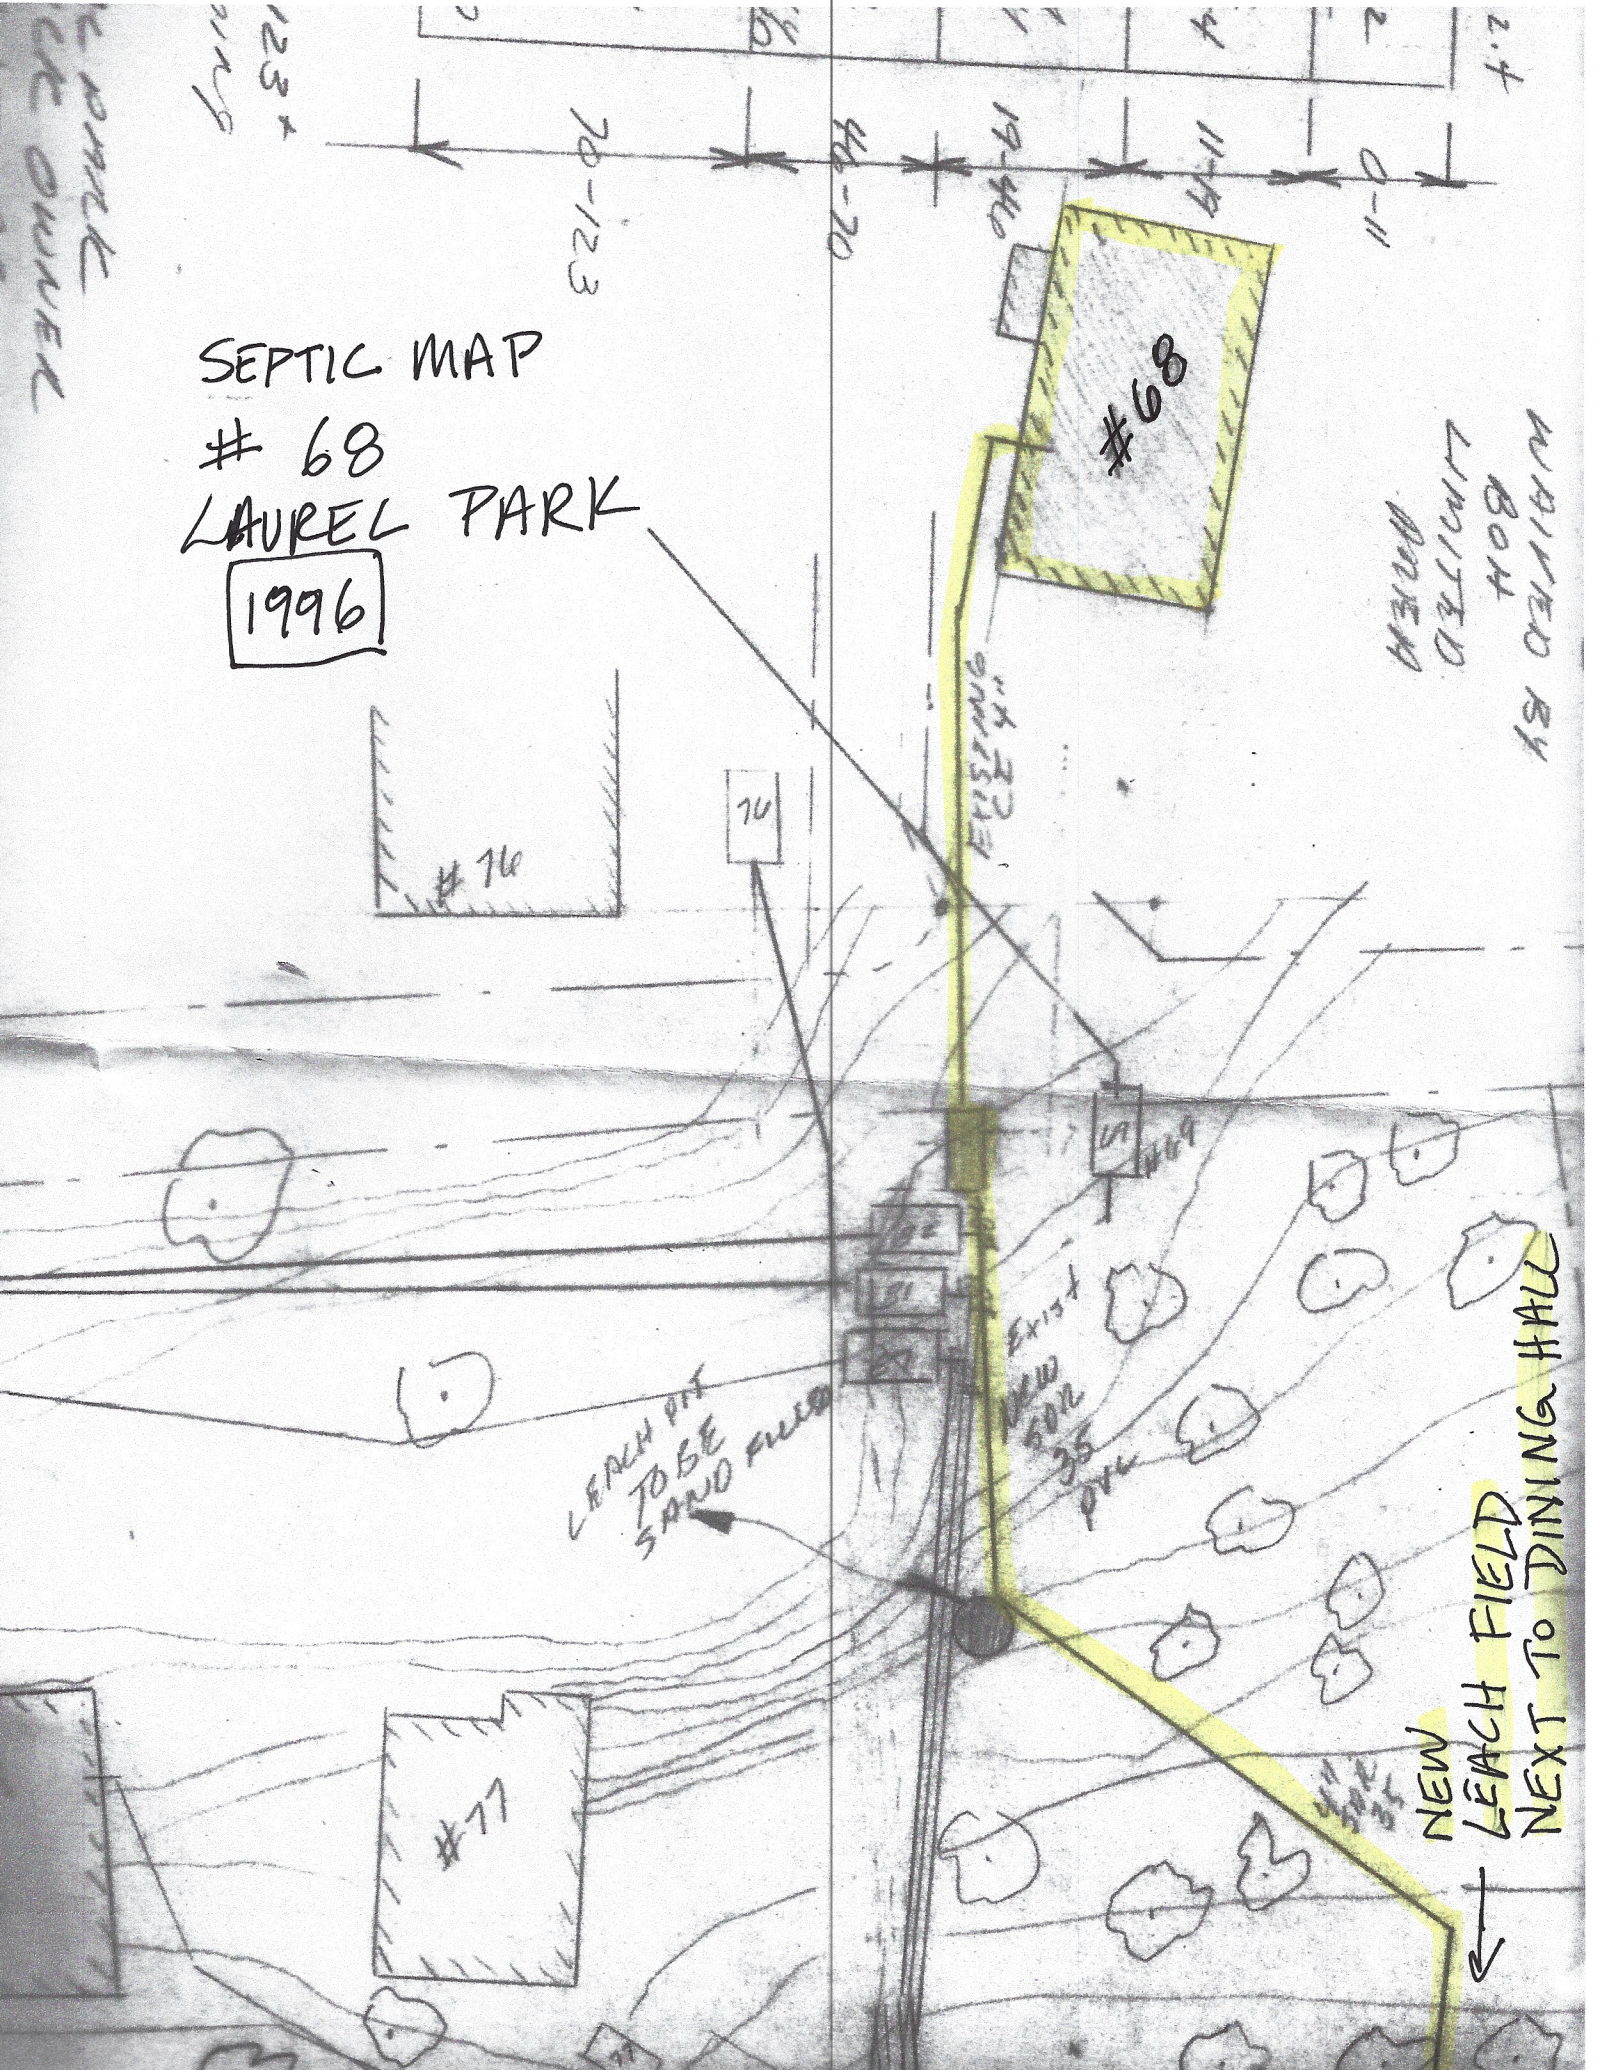

LEACH PIT  
TO BE  
SAND FILL

EXIST  
NEW  
4" PIPING

NEW  
LEACH FIELD  
NEXT TO DINING HALL

#77

#68

76

#76

EXISTING  
4" PIPING

123  
123

2.4

0-11

11-19

19-40

40-70

70-123