



LINES DRAWN FOR SEPTIC LOCATION PURPOSES ONLY!

D BOX

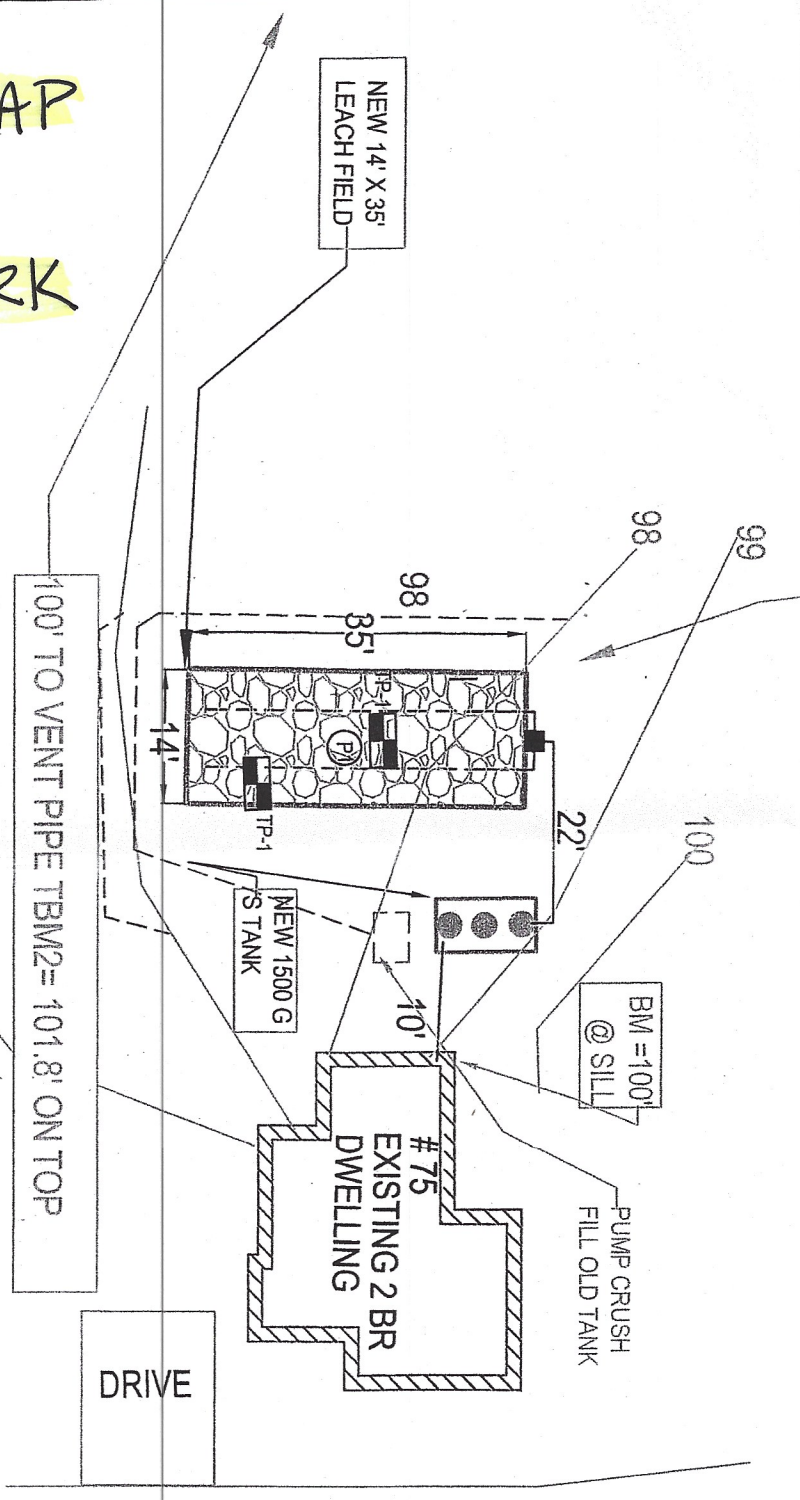

SEPTIC MAP
#75
LAUREL PARK
2016

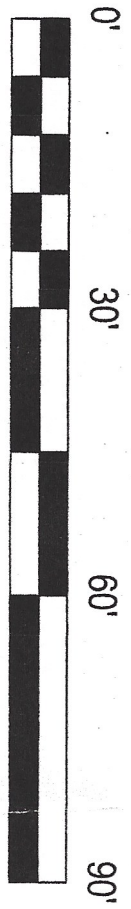

GRAVITY SLOPE SEPTIC SYSTEM OPERATION AND MAINTENANCE
 1.) HAVE TANK PUMPED EVERY 2 YEARS. 2.) MAINTAIN AREA OVER TANK.
 3.) DO NOT PLANT ANY TREES OR DEEP ROOTING SHRUBS WITHIN 10' OF TANK.
 LOW FLOW WASHERS.



TEST PIT 1			
DEPTH:	HORIZ.:	TEXTURE:	MOISTURE:
0-10"	A	FSL	
10-22"	B	FSL	
22-90"	C1	FS	
OXIDES:			
EHWT:			
STANDING H2O:			
WEEPING:			
BEDROCK:			

ATTENTION INSTALLER!!

CALL DIG SAFE BEFORE YOU DIG!! MASSACHUSETTS STATE LAW CHAPTER 82 SECTIONS 40 - 40E REQUIRE THAT PREMARKING OF GAS, ELECTRIC, WATER, TELEPHONE AND CABLE T.V. UTILITY

NOTE: INSTALLER MUST SUBGRADE INSPECTION IN PLACE PRIOR TO SIG