


Unit # 77 - May Not be Current Septic Map
William Sierotta - Engineer

SKETCH PLAN

Show the tank location with the distance triangulated from any two points on the house which the tank serves.

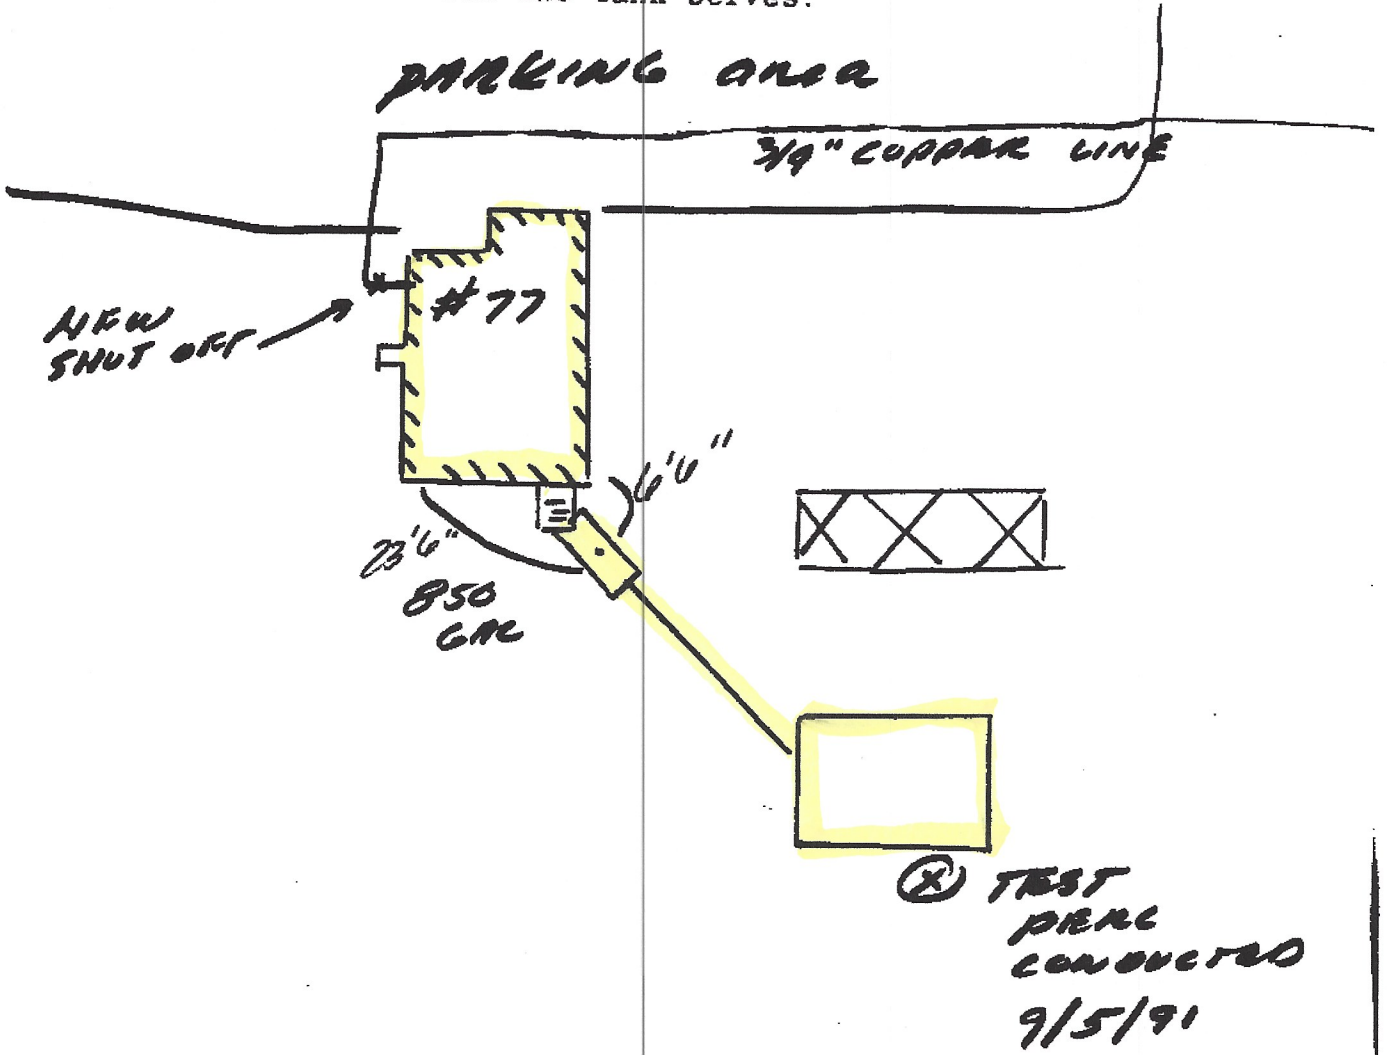

Signed William J. Sierotta
Title WILLIAM J SIEROTTA
Date 9/19/91



Send one copy each to the following, within seven (7) days: