


SEPTIC MAP
81
LAUREL PARK

1991

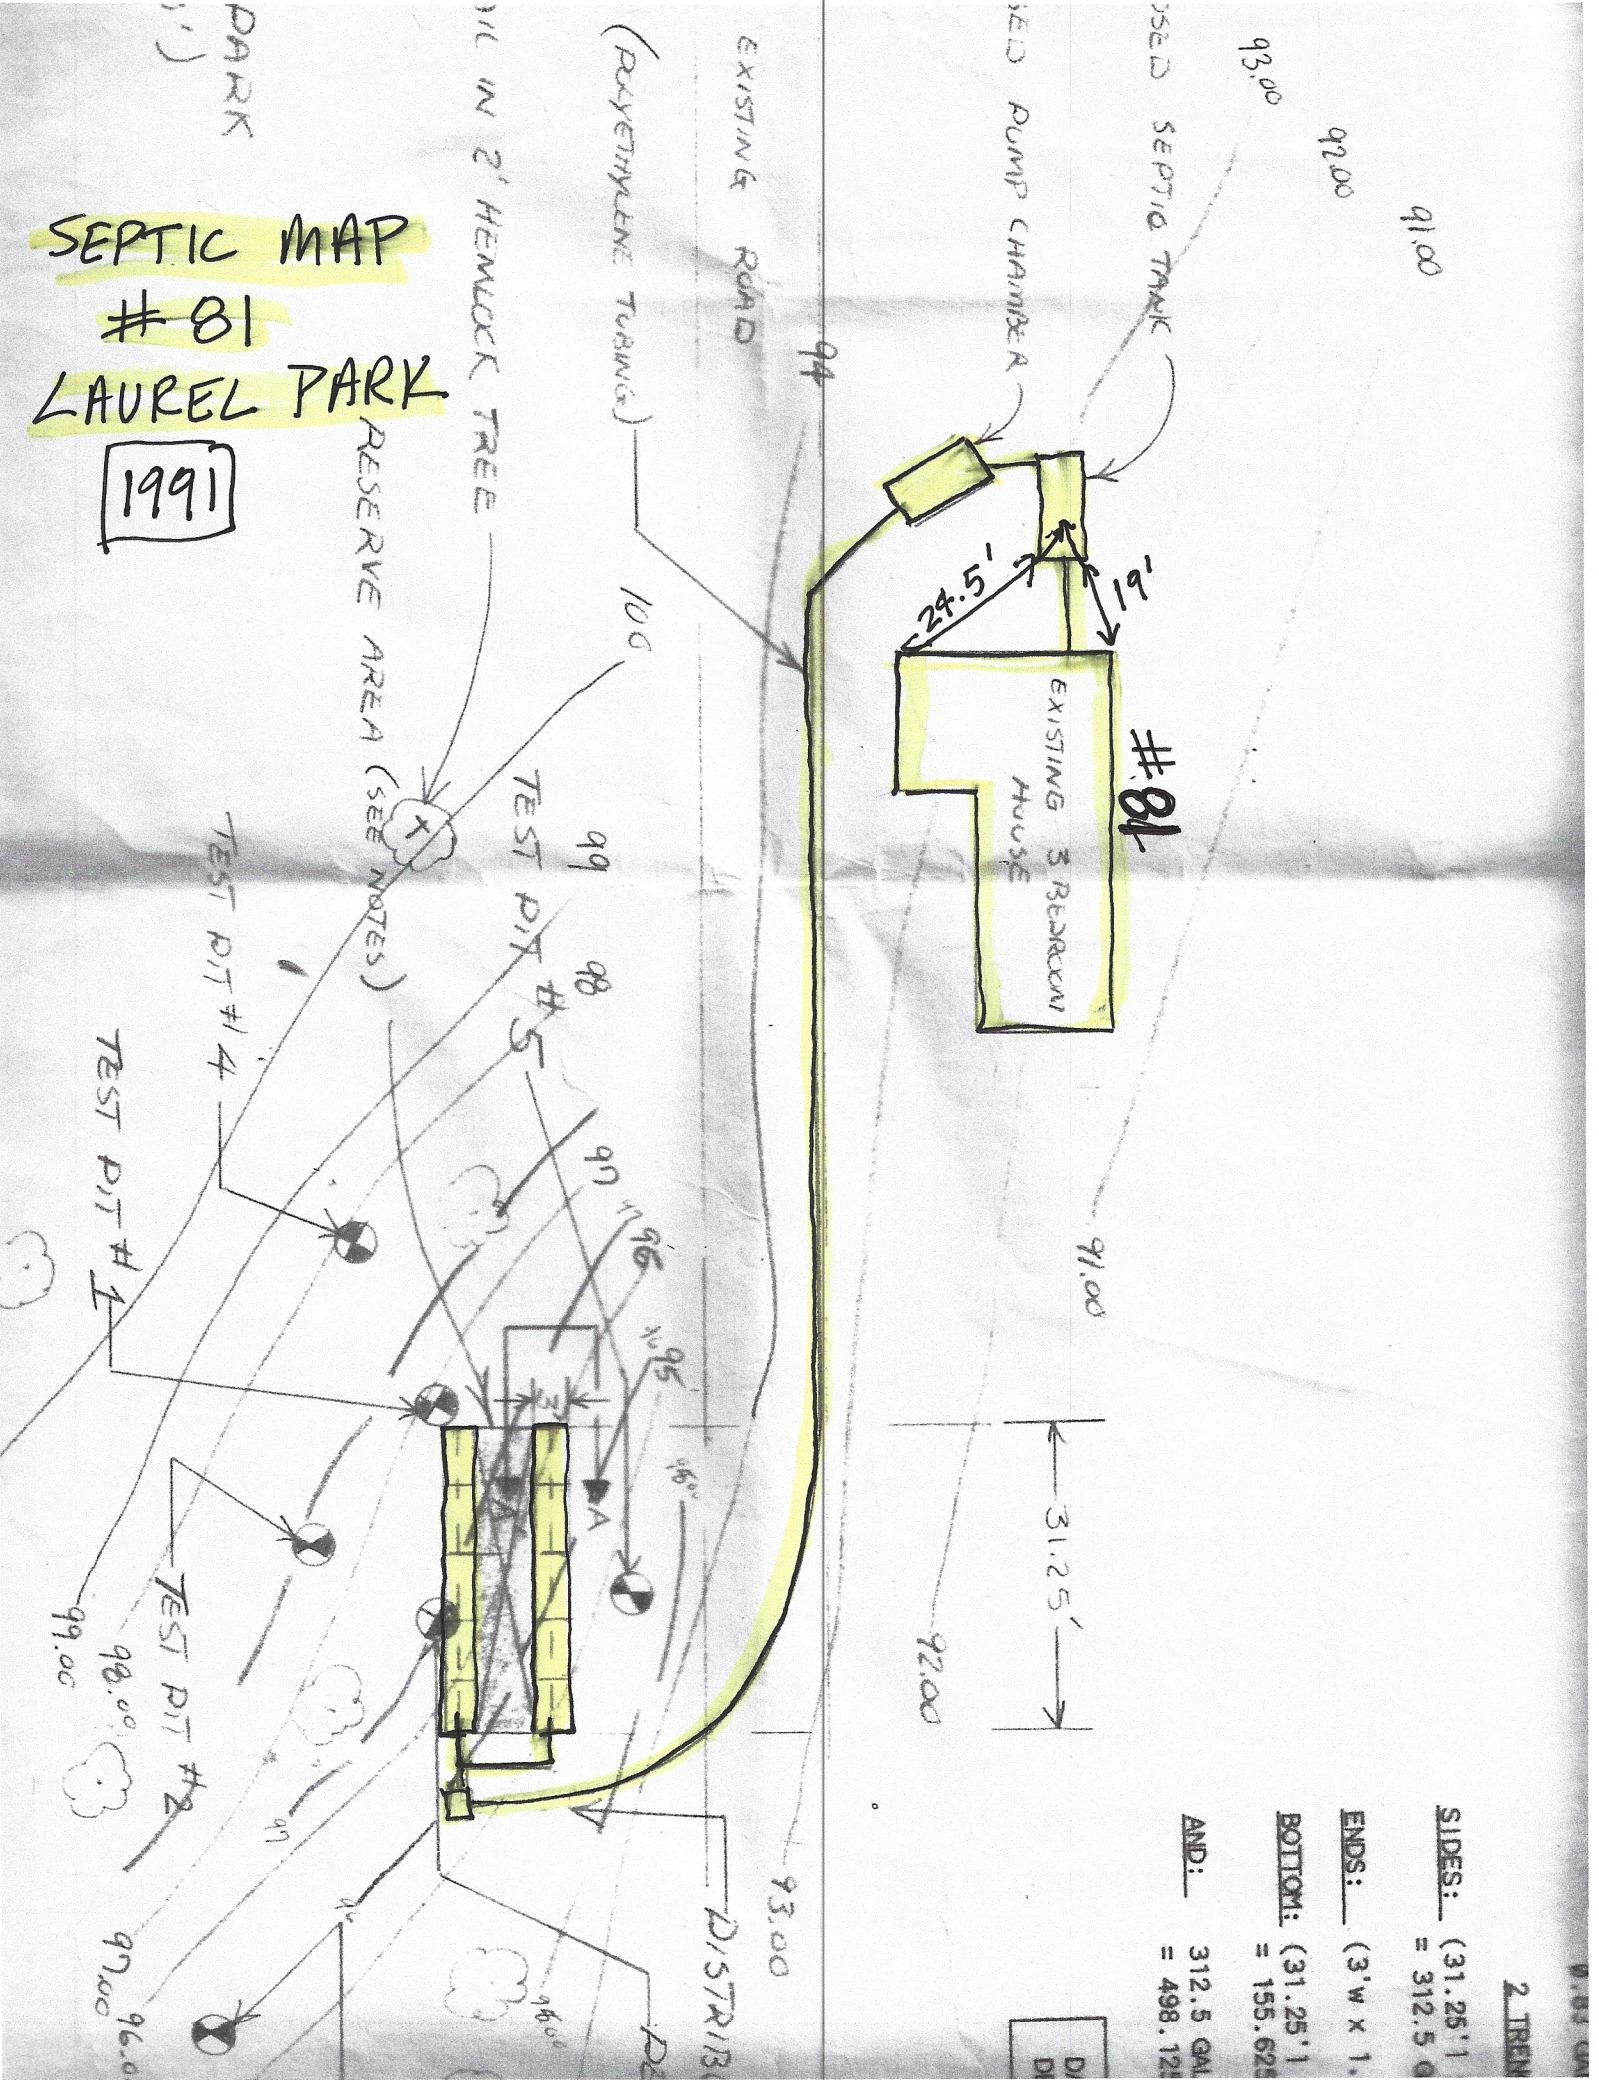

2 TREN	
SIDES: (31.25' x 1)	
= 312.5	
ENDS: (3' W x 1)	
BOTTOM: (31.25' x 1)	
= 155.625	
AND: 312.5 GAL	
= 498.125	