



# SEPTIC MAP # 84 LAUREL PARK.

☆  
See  
Map  
Below

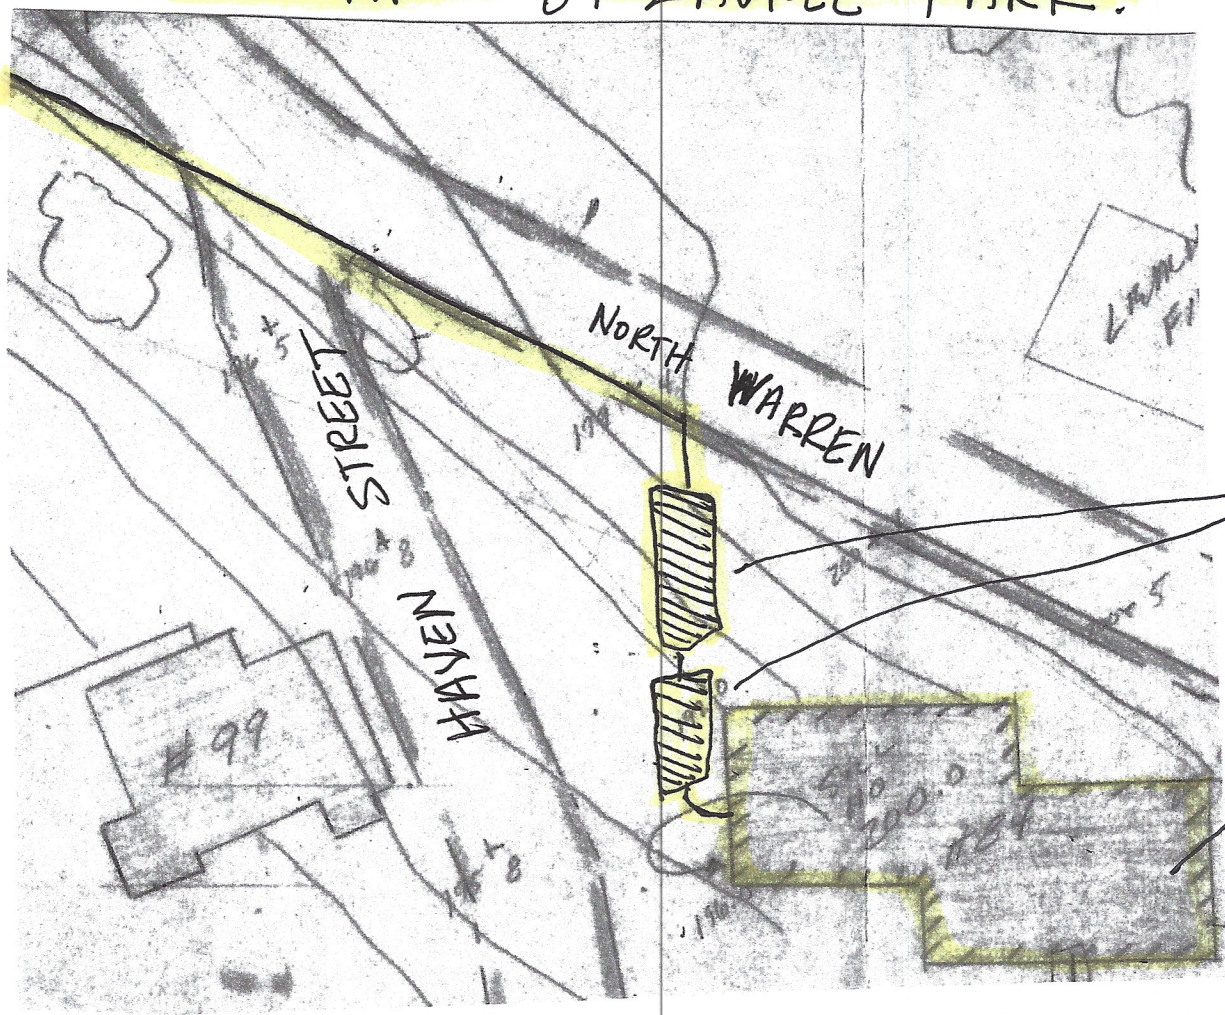

SEPTIC  
TANK  
and  
PUMP

#84

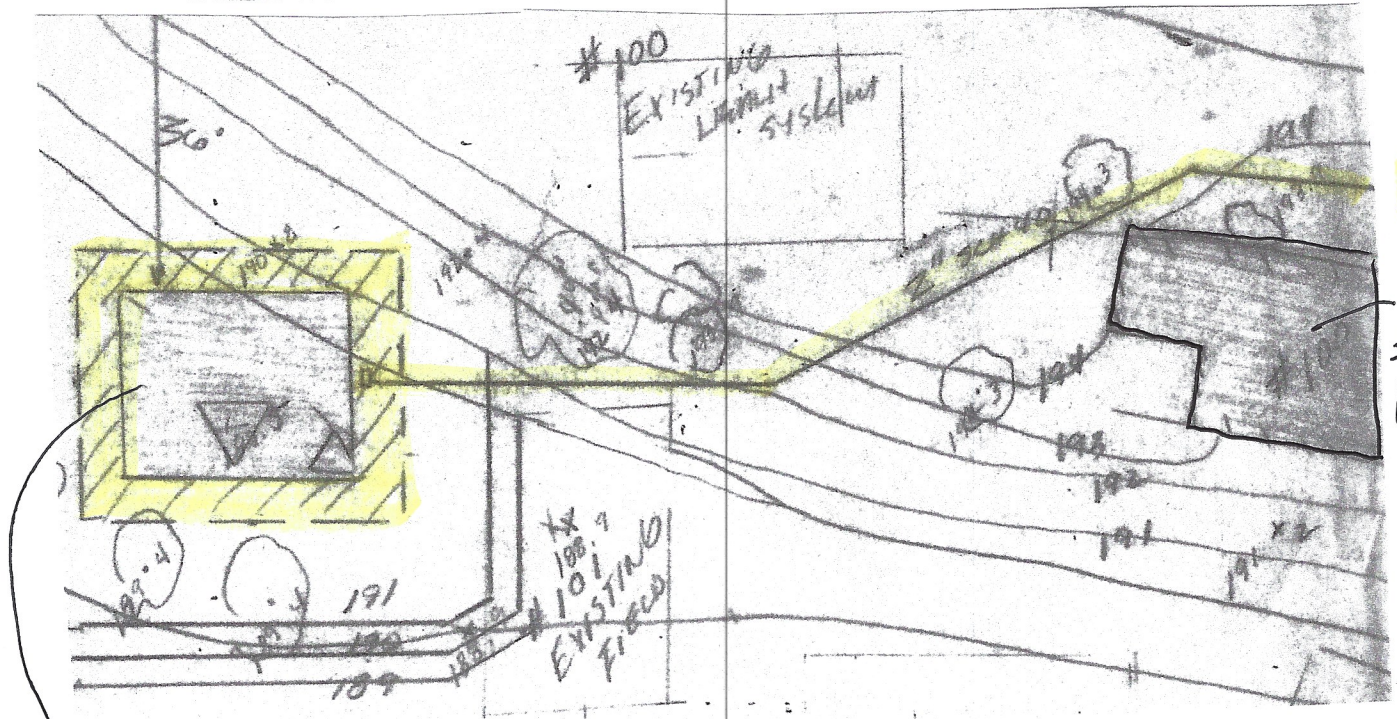

☆

#100

LEACH FIELD (along Coles Meadow Road  
for #84 Behind #100)