


SEPTIC
MAP

87

LAUREL
PARK

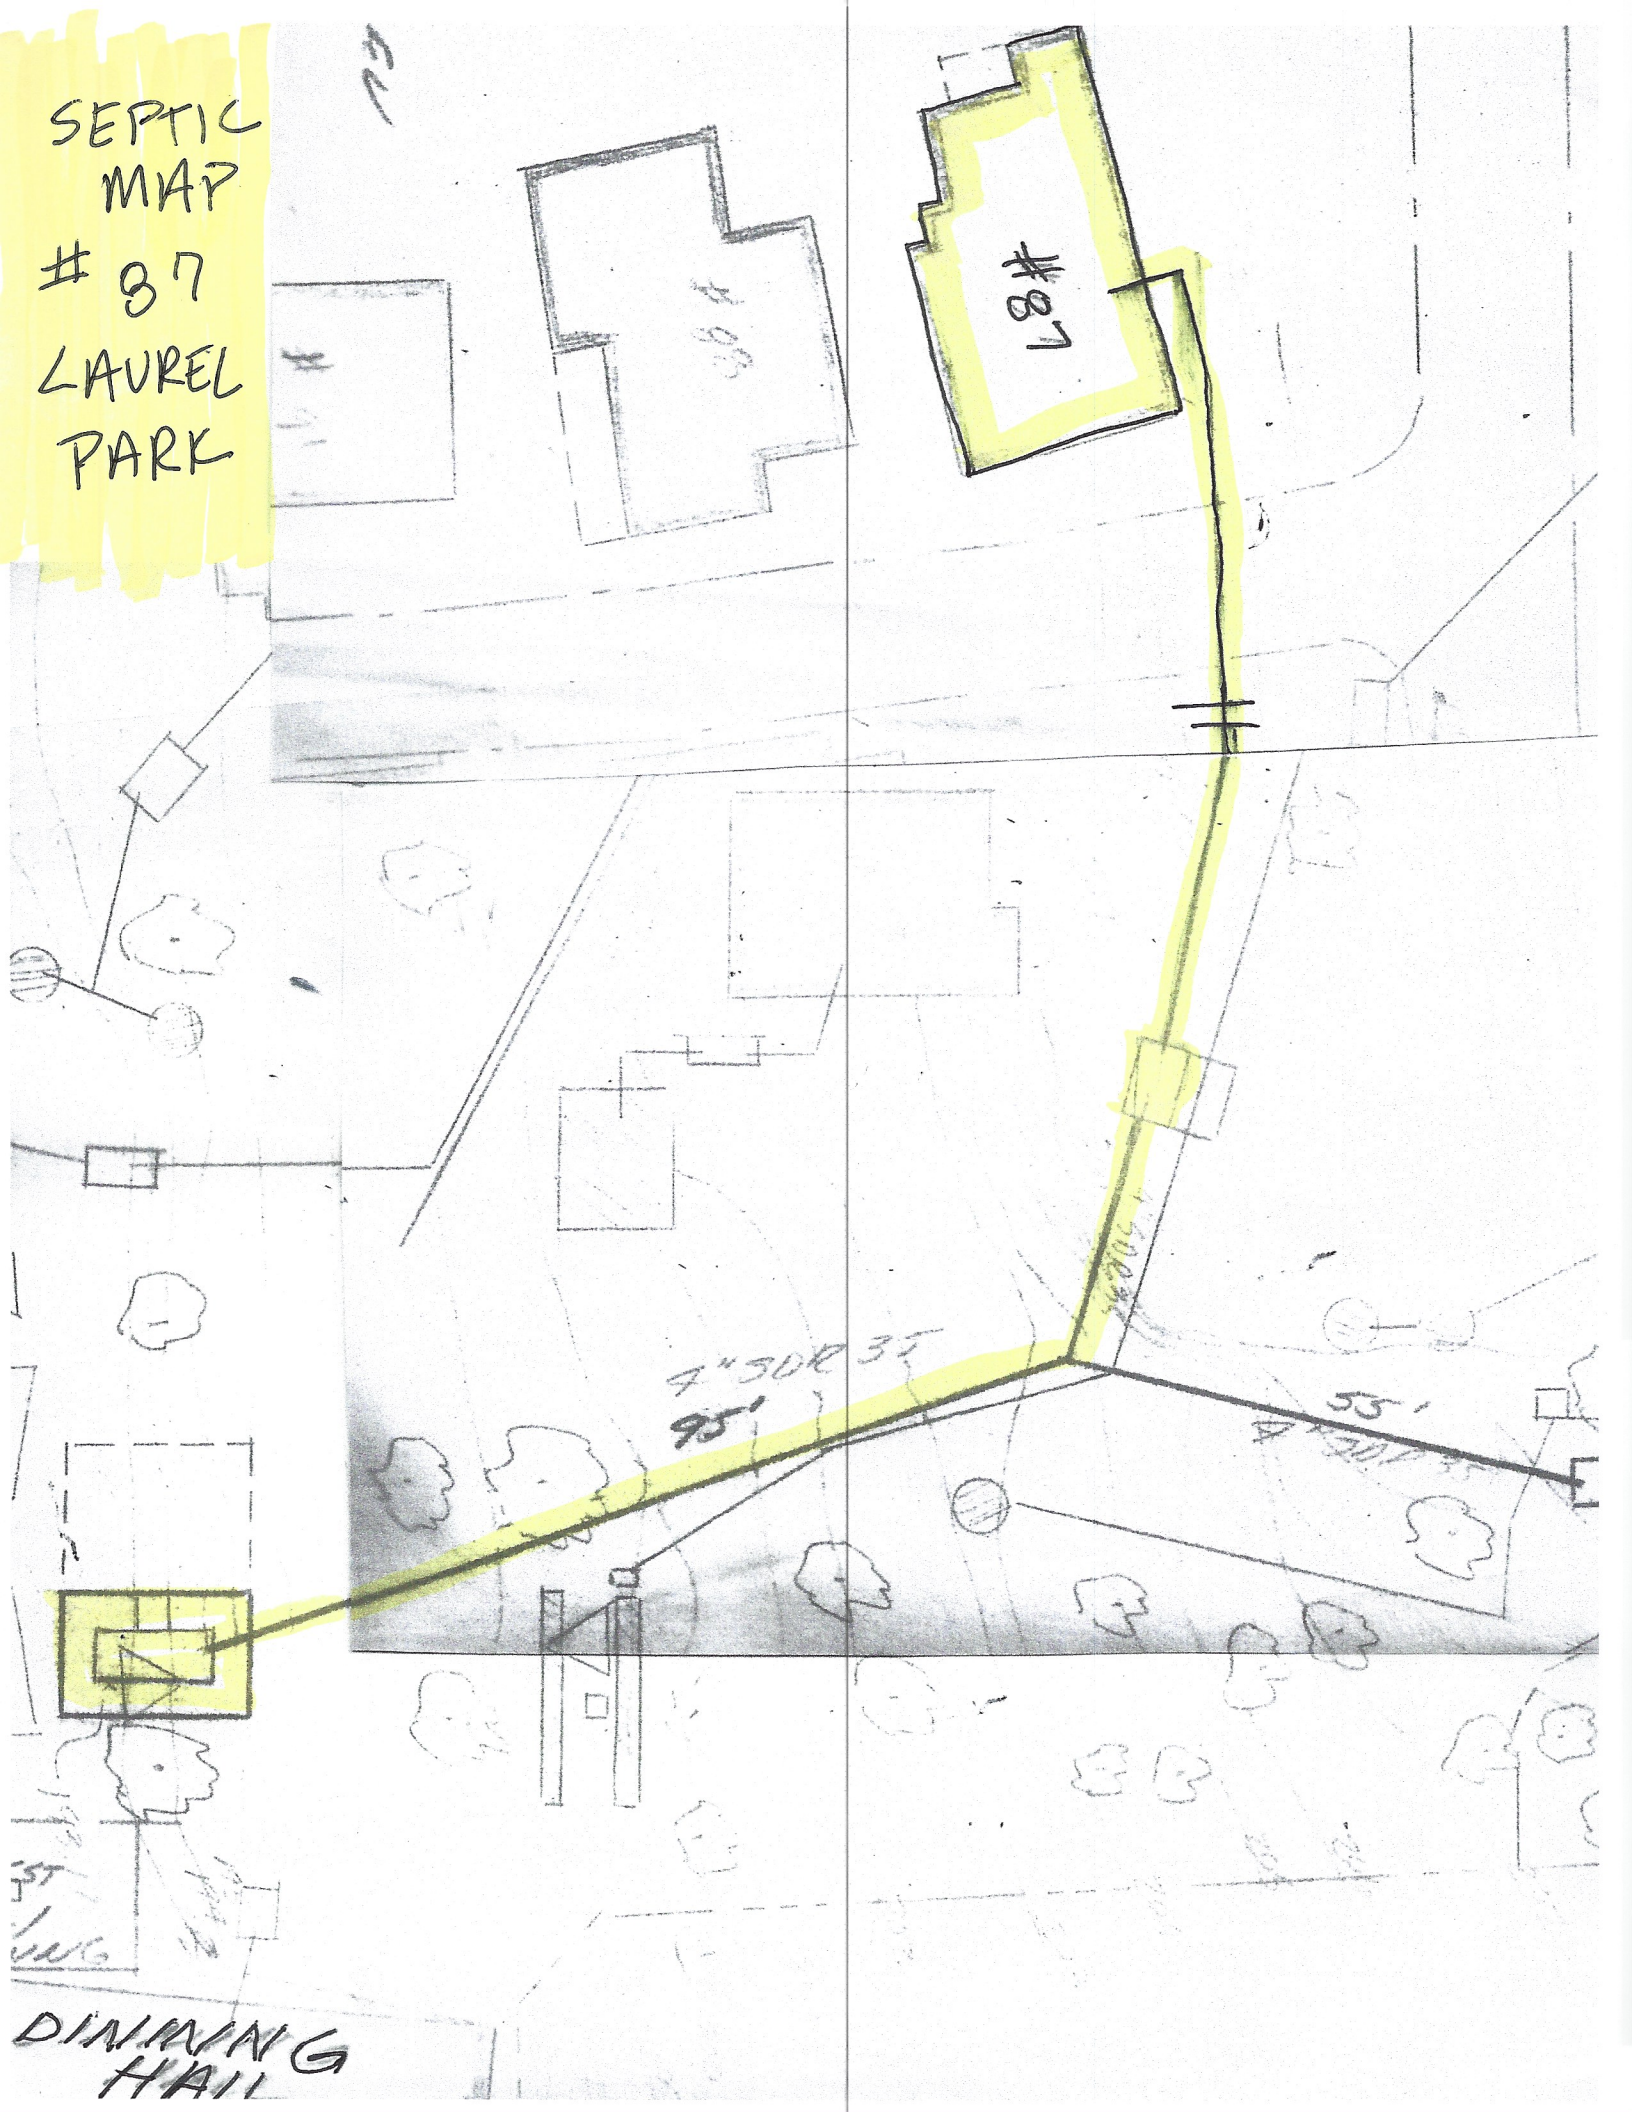

4" 30" 35" 95"

55"

4" 30" 35" 95"

35"
LONG

DINING
HALL