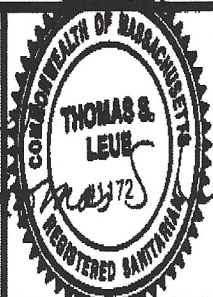


Note: no known drinking water sources within 100 foot radius.

Unit # 88
 Septic Map
 William Sieruta - Engineer

As-Built Drawing Existing Septic System	Date: 1/20/2016	Owner: Jennifer Snyder 88 Laurel Park Northampton, MA 01060		HOMESTEAD INC. Thomas S. Leue R.S. 1664 Cape St. Williamsburg, MA 01096 [413] 628-4533
Scale: 1 : 20' Except as Noted	Revision Date:			