
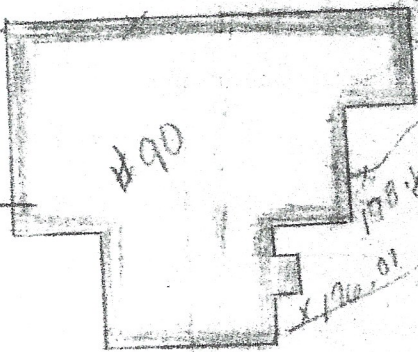



SEPTIC MAP  
# 89  
LAUREL PARK

EDGE OF ROAD

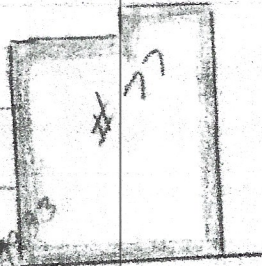

REPORTED  
500 GPD  
5' x 5' TANK

PHAC  
TANK  
PIT

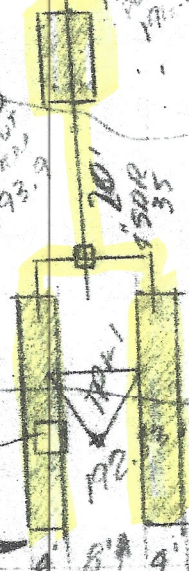

30" OAK  
193.2

EDGE OF ROAD

191.83

82'

192

194

190

STONE WALL

203

202

45'

200

200

178.75

190.01

20'

179.0

30'

191.2

20'

193.5

192.3

193.5

4'

8'

4'

191.83

X

105' 11 1/2'

40'