


Unit # 91 - Septic Map - 2010

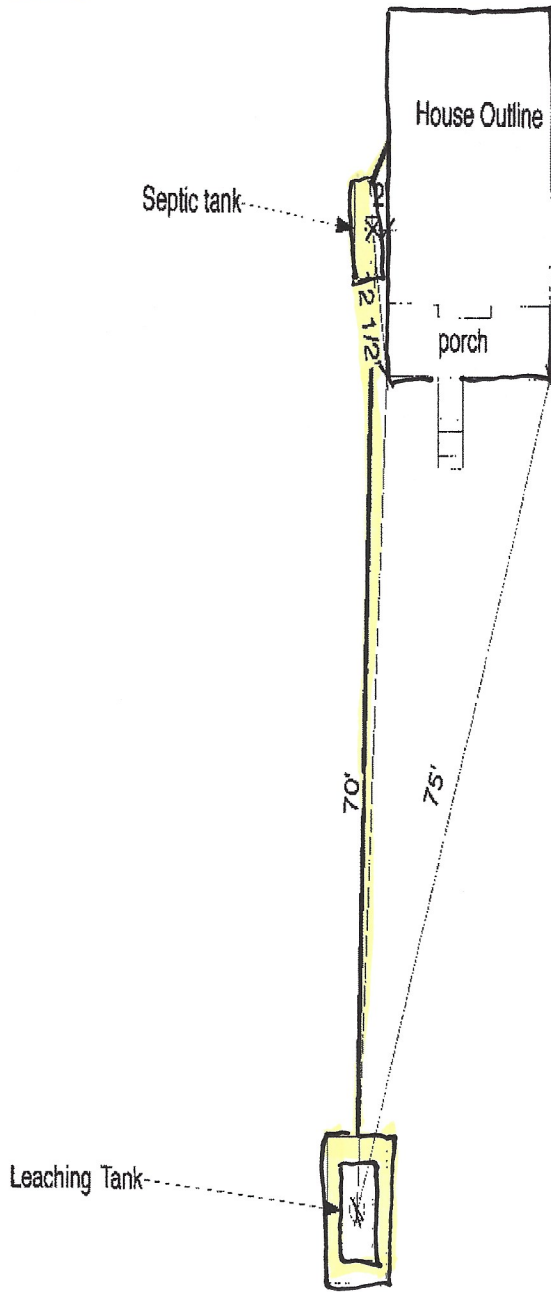

Note: No known drinking water sources within 100 foot radius.

As-Built Drawing Existing Septic System	Date: 8/20/2010	Owner: Donna Taylor 91 Laurel Park Northampton, MA 01060		HOMESTEAD INC. Thomas S. Leue R.S. 1664 Cape St. Williamsburg, MA 01096 (413) 628-4533
Scale: 1 : 20' Except as Noted	Revision Date:			