

OFFICIAL INSPECTION FORM - NOT FOR VOLUNTARY ASSESSMENTS
SUBSURFACE SEWAGE DISPOSAL SYSTEM INSPECTION FORM
PART C
SYSTEM INFORMATION (continued)

Property Address: 93 Laurel Park


Owner: Antal

Date of Inspection: 9/10/03

Septic System Map
93 Laurel Park

SKETCH OF SEWAGE DISPOSAL SYSTEM

Provide a sketch of the sewage disposal system including ties to at least two permanent reference landmarks or benchmarks. Locate all wells within 100 feet. Locate where public water supply enters the building.

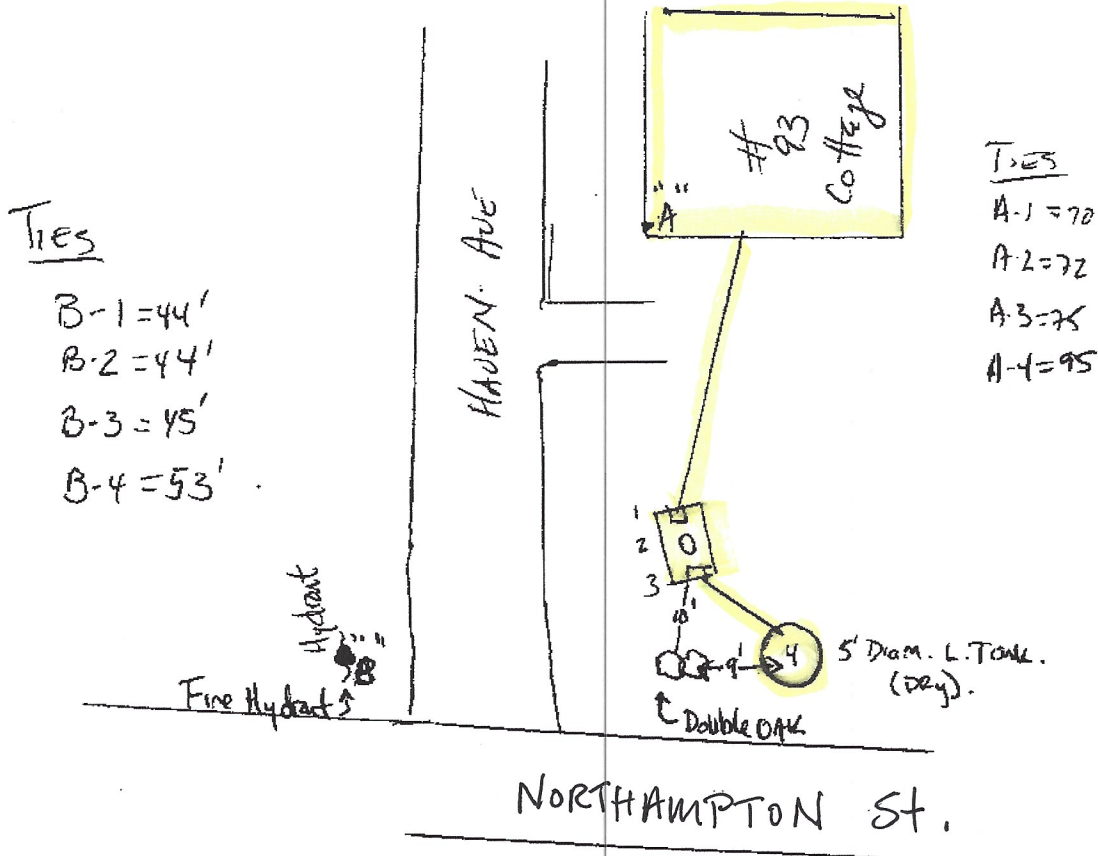

Ties

- B-1 = 44'
- B-2 = 44'
- B-3 = 45'
- B-4 = 53'

TIES

- A-1 = 70
- A-2 = 72
- A-3 = 75
- A-4 = 95