


INSTALLATION NOTES

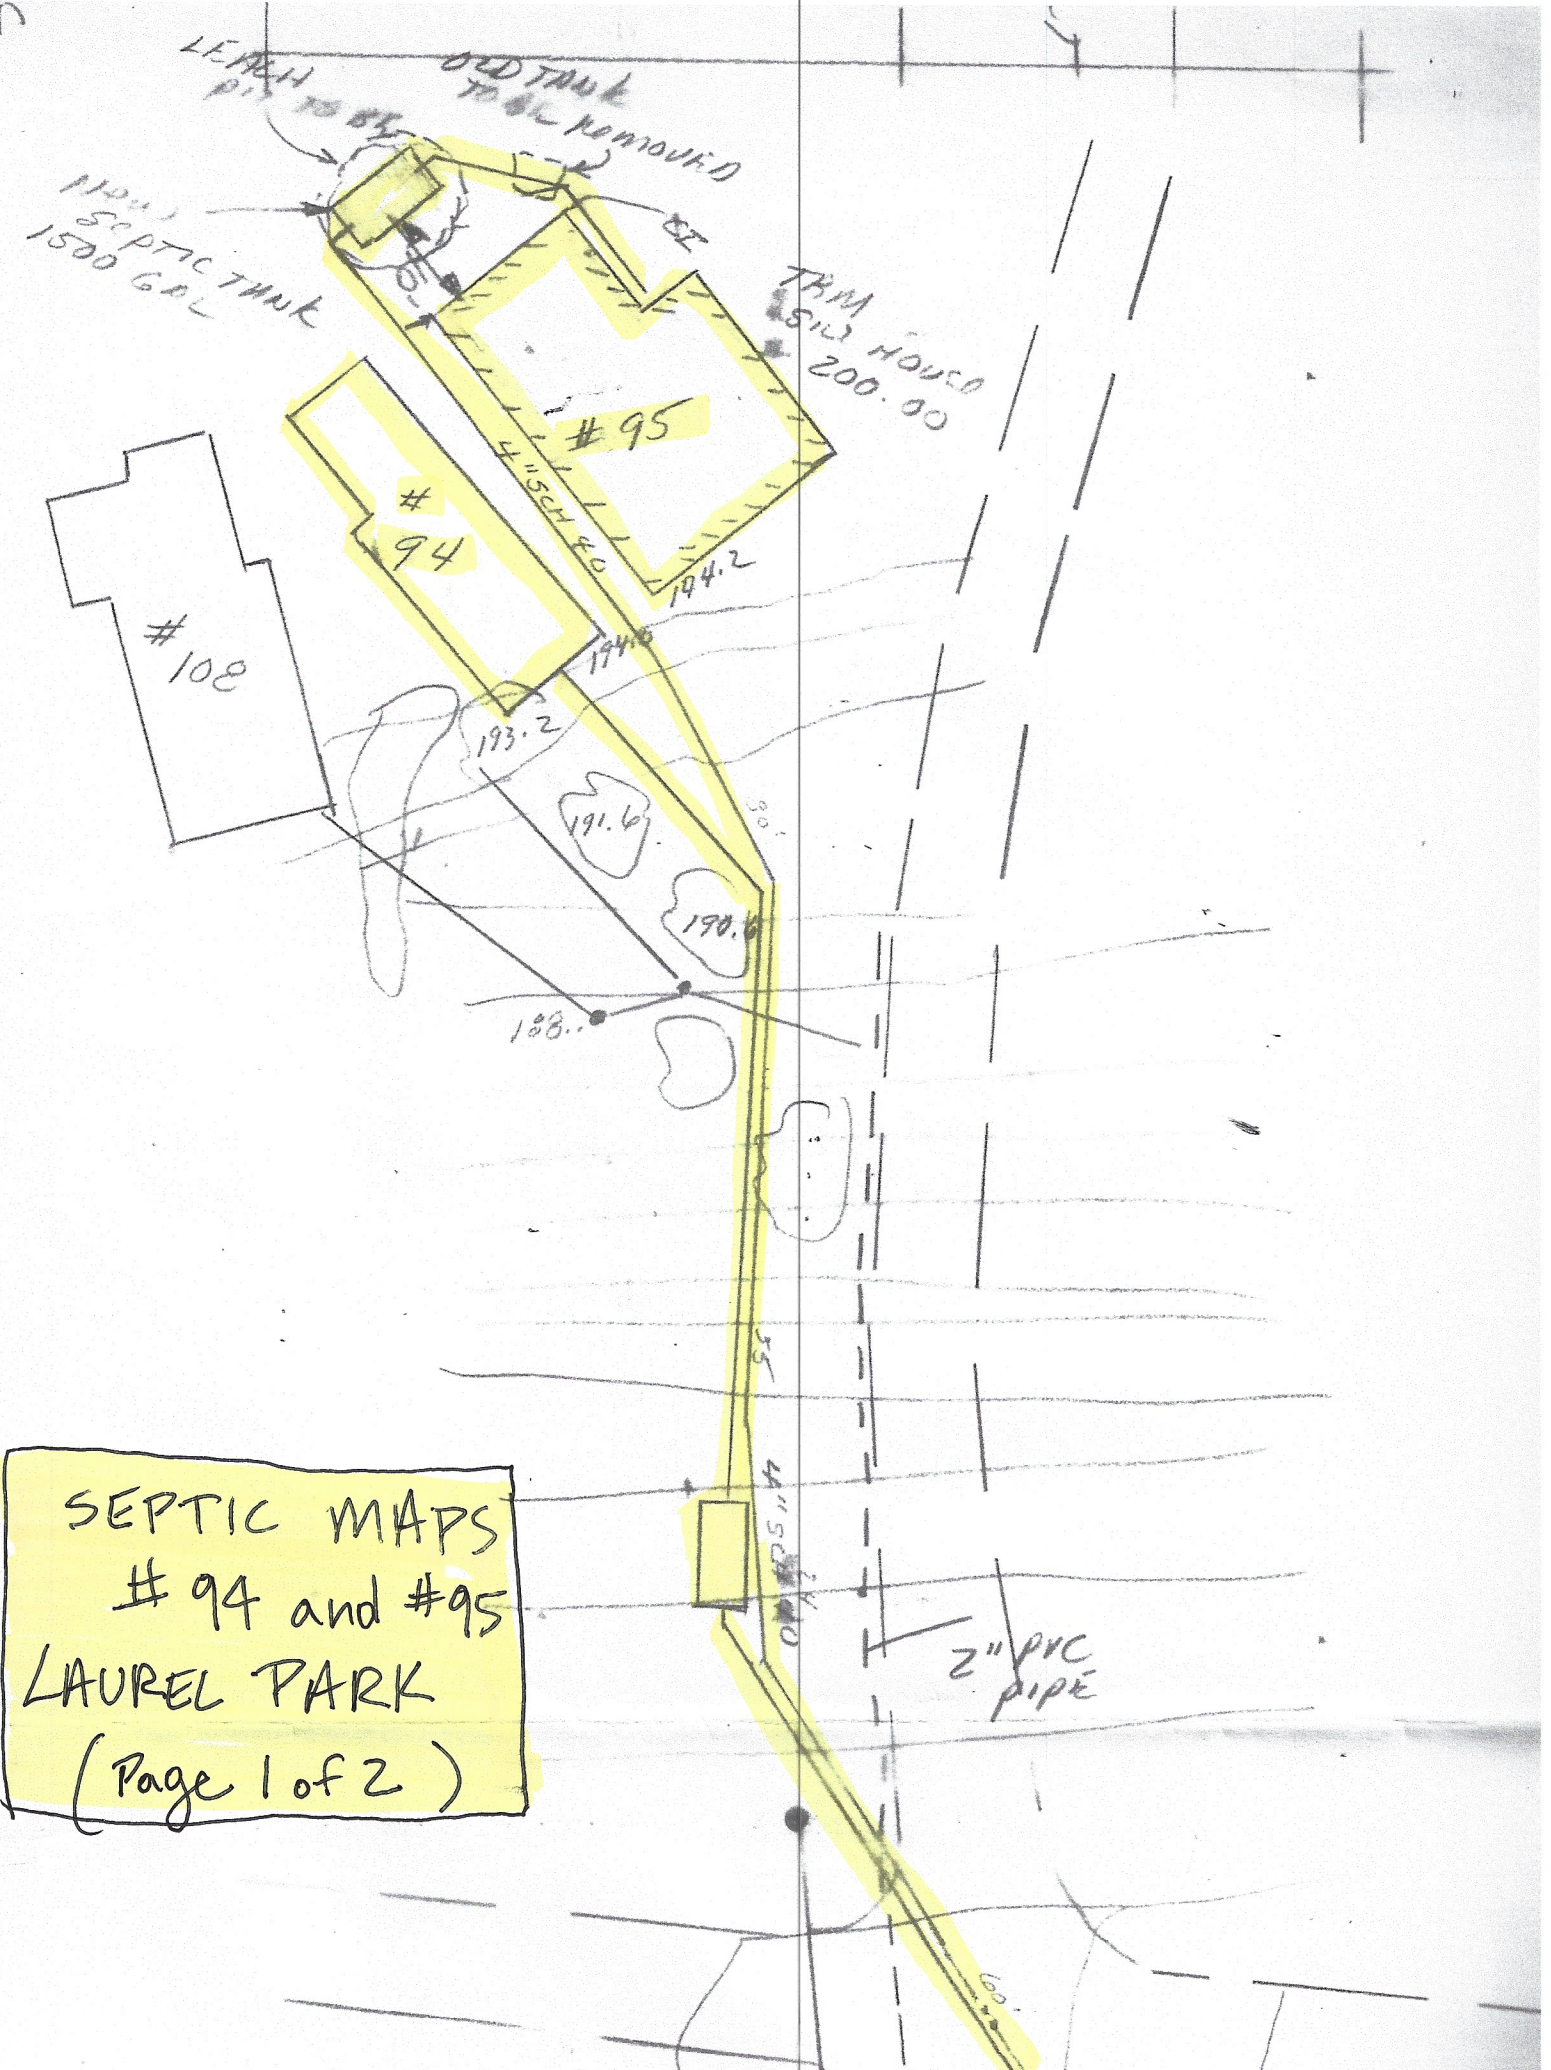

SEPTIC MAPS
 # 94 and # 95
 LAUREL PARK
 (Page 1 of 2)

174.66

110

177.1

176.30

55.104

175.96

176.5

55.104 x 76.9

176.1

95

175

170

175

175

170

177.8

176.7

94

METER PIT

TOP METAL PIT COVER

#114

#115

#95

15 x 30

#94

LEACH FIELD

SEPTIC MAPS #94 and #95 LAUREL PARK (Page 2 of 2)

SCALE 1" = 20 FT

