


SEPTIC MAP
 # 96
 LAUREL PARK
 2014

SEPTIC TANK
 (HOMESTEAD INC.
 4/23/2014)

LEACH FIELD
 480' AWAY
 * PUMP TANK

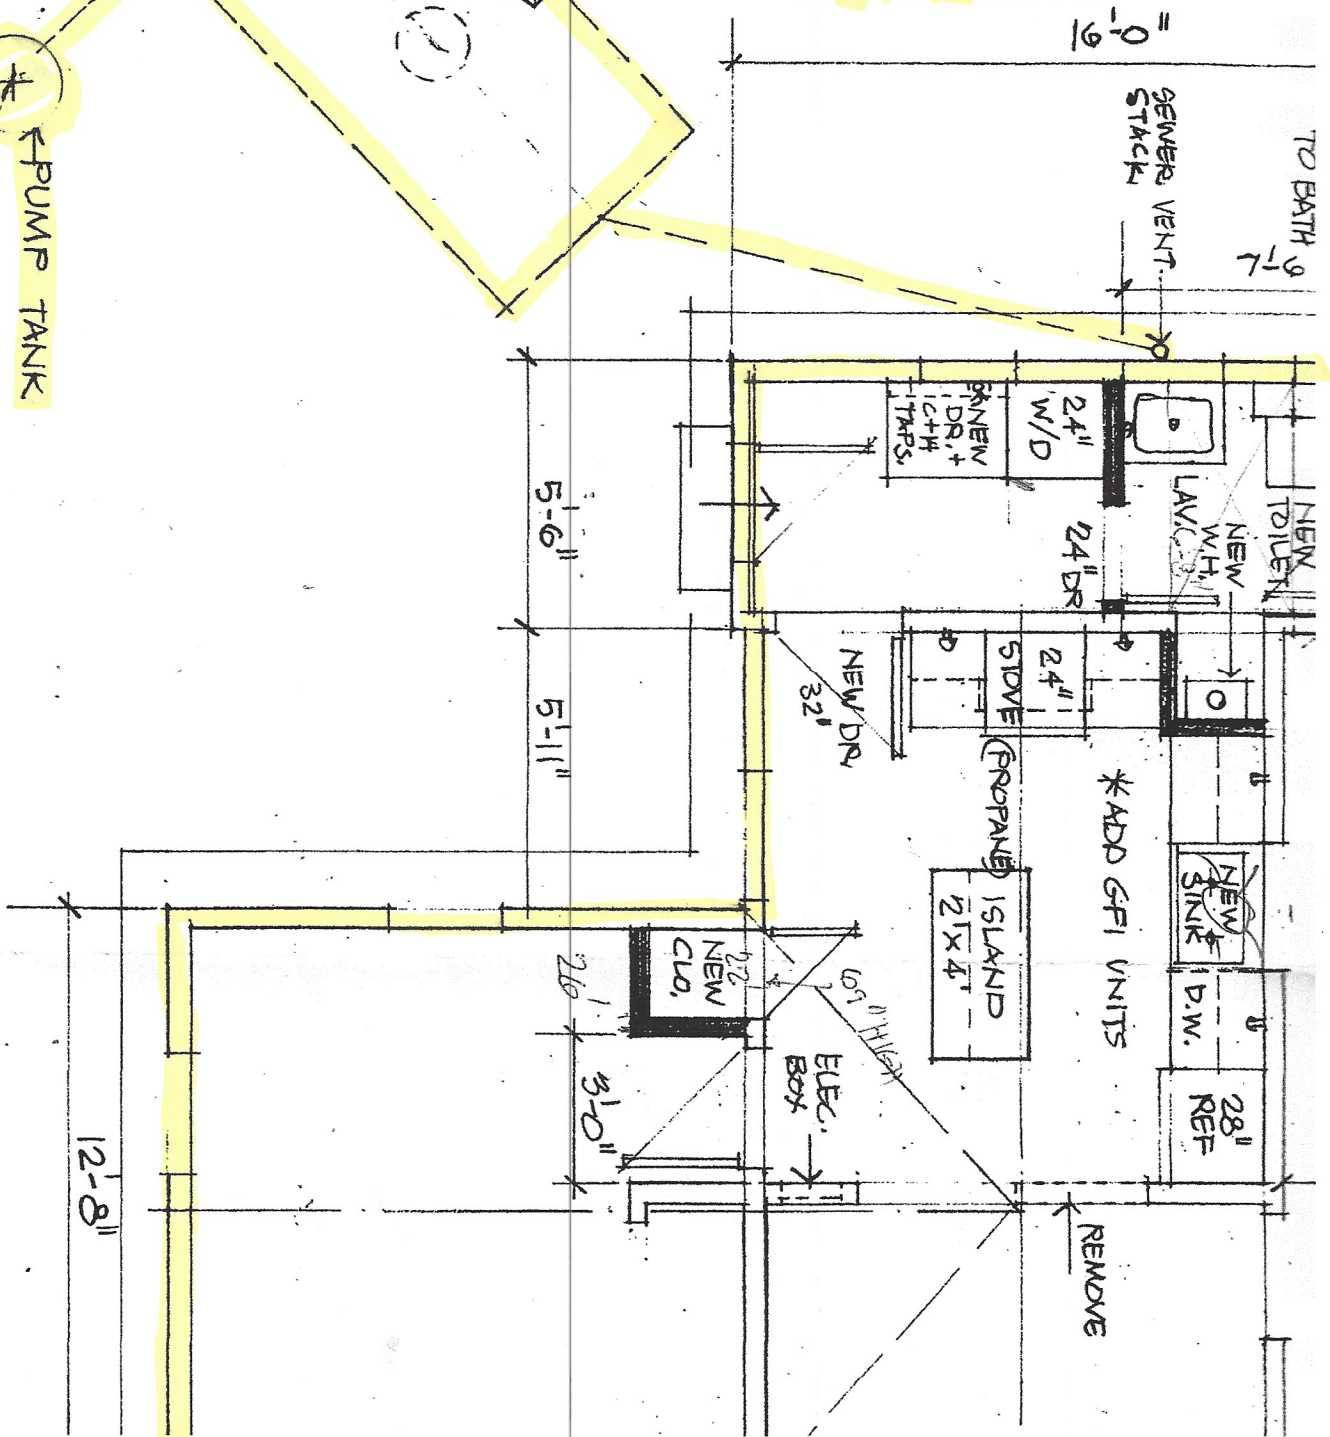

PLAN OF EXISTING CONDITIONS WITH NOTED