

Unit #100 - Septic Map

LAUREL PARK

2008


2008 SEPTIC PLAN ADDENDUM

DUE TO LATE REGULATION CHANGES 4-22-2006

ALL NEW SYSTEMS MUST:

- 1.) INSTALL PVC RISERS OVER D. BOX'S BURIED DEEPER THAN 9" AN PLACE IRON REBAR ON TOP.
 - 2.) HAVE 4" PERFORATED, PVC INSPECTION PORTALS TO BOTTOM OF STONE BED, WITH SCREW RISER TO 3" OF SURFACE, MARKED WITH REBAR. *All OPENINGS & COMPONENTS marked with magnetic tape*
 - 3.) HAVE PERFORATIONS IN BED AT 4 AND 8 O-CLOCK POSITIONS.
- NOTE: THESE ARE NEW STATE REGULATION REQUIREMENTS (4-22-06), NOT NECESSARILY THE OPINION OF THE DESIGNER.

NOT AN ACTUAL SURVEY!!
LINES DRAWN FOR SEPTIC LOCATION PURPOSES ONLY!

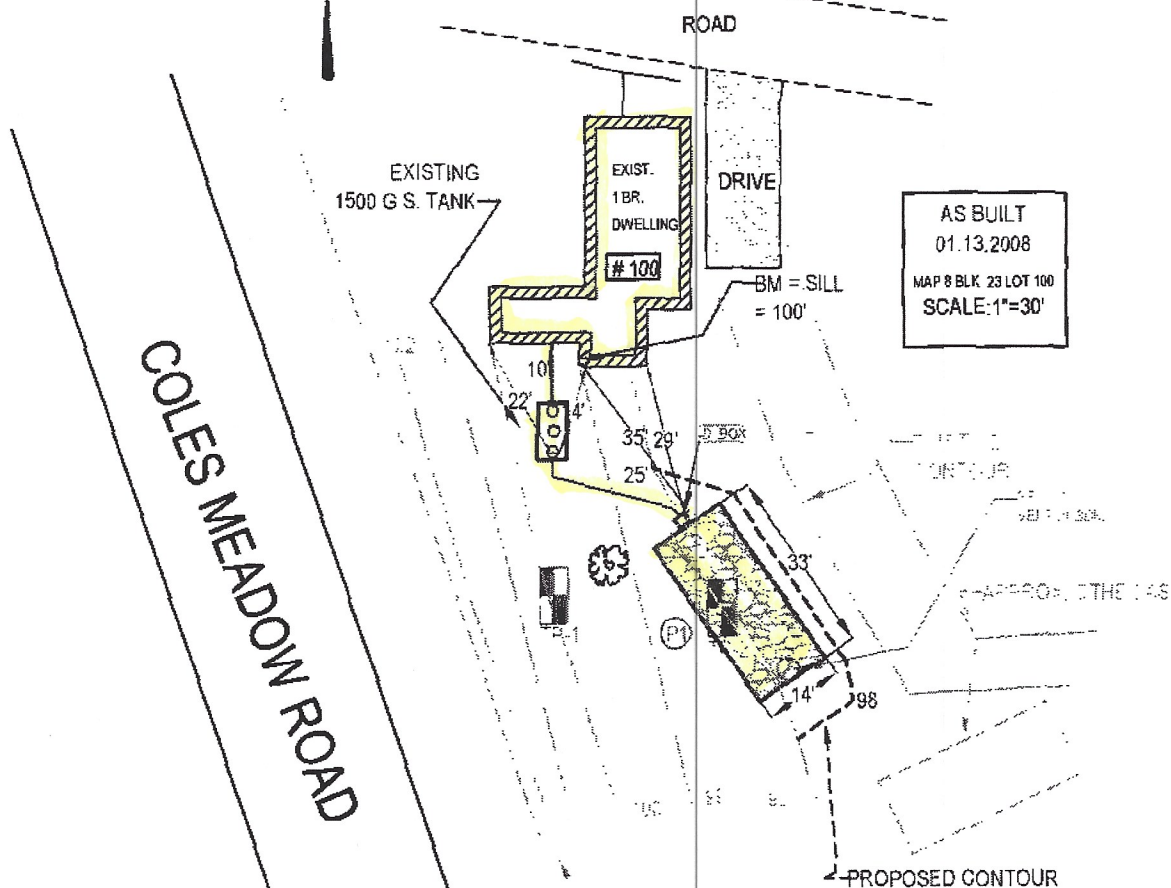

AS BUILT
01.13.2008
MAP 8 BLK 23 LOT 100
SCALE: 1"=30'

USE TEE OR
-RUN PIPES!
-PLACE WATER
FOR FINAL IF

4" SCH. 40
FROM S. TAP

FIELD MARKS OF LOT 100

GRAVITY SLOPE SEPTIC SYSTEM OPERATION AND MAINTENANCE NOTES FOR HOMEOWNER.

- 1.) HAVE TANK PUMPED EVERY 2 YEARS.
- 2.) MAINTAIN AREA OVER SEPTIC SYSTEM AS GRASSY OR SIMILAR GROUND COVER.
- 3.) DO NOT PLANT ANY TREES OR DEEP ROOTING SHRUBS WITHIN 10 FEET OF SYSTEM.
- 4.) USE ONLY LIQUID DETERGENTS & LOW FLOW WASHERS.