

Unit # 101 - Septic Map LAUREL PARK

2000

SUBSURFACE SEWAGE DISPOSAL SYSTEM INSPECTION FORM

J. HARPER

PART C

SYSTEM INFORMATION (continued)

101 LAUREL PARK


Property Address: NORTHAMPTON AVE

Owner:

Date of Inspection: 8/28/00

SKETCH OF SEWAGE DISPOSAL SYSTEM:

include ties to at least two permanent references landmarks or benchmarks
locate all wells within 100' (Locate where public water supply comes into house)

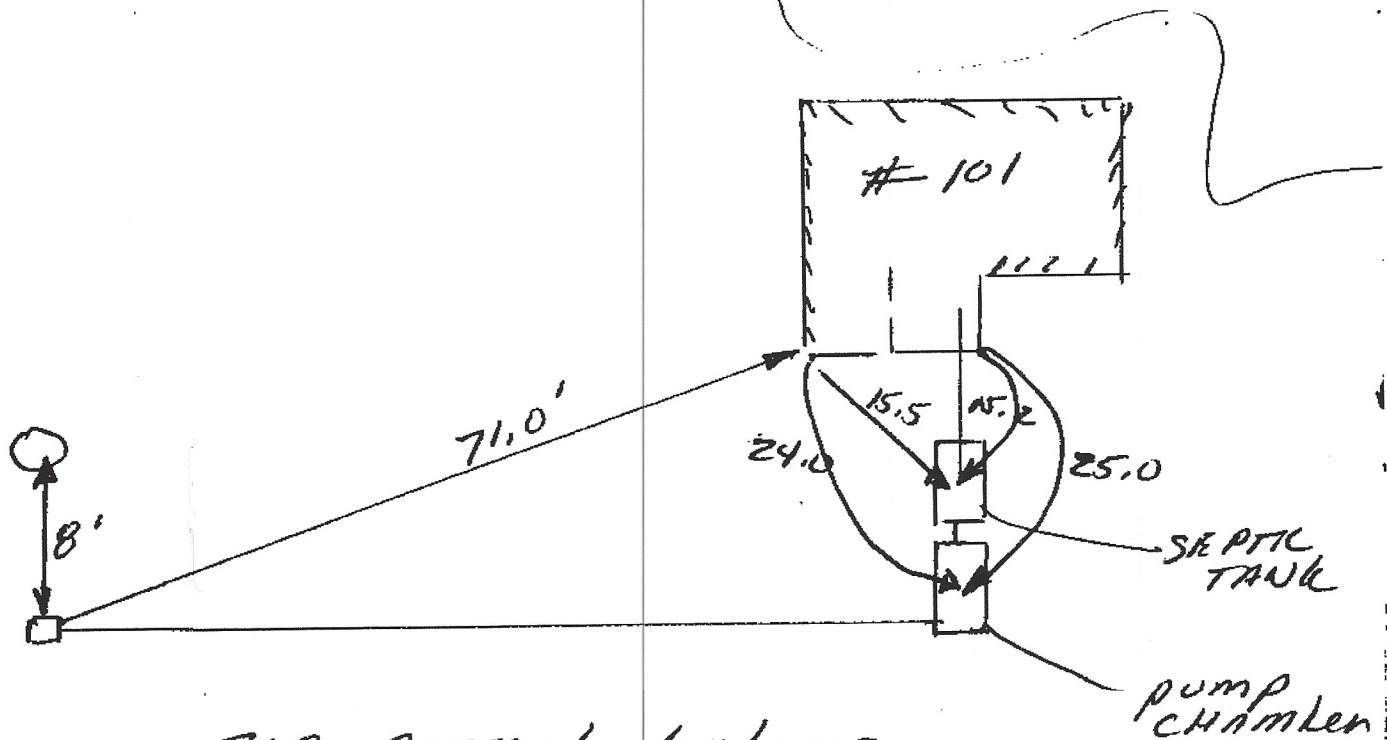

SEE ATTACHED PLANS
FOR DETAILS
& ADDITIONAL AS BUILT
TIES.