

Unit # 102

Septic Maps



Commonwealth of Massachusetts

Title 5 Official Inspection Form

Subsurface Sewage Disposal System Form - Not for Voluntary Assessments

102 LAUREL PARK

Property Address

RUSSELL GATELY

Owner's Name

NORTHAMPTON

City/Town

MASS
State


01060
Zip Code

MARCH 15, 2008
Date of Inspection

Owner information is required for every page.

D. System Information (cont.)

Sketch Of Sewage Disposal System: Provide a sketch of the sewage disposal system including ties to at least two permanent reference landmarks or benchmarks. Locate all wells within 100 feet. Locate where public water supply enters the building.

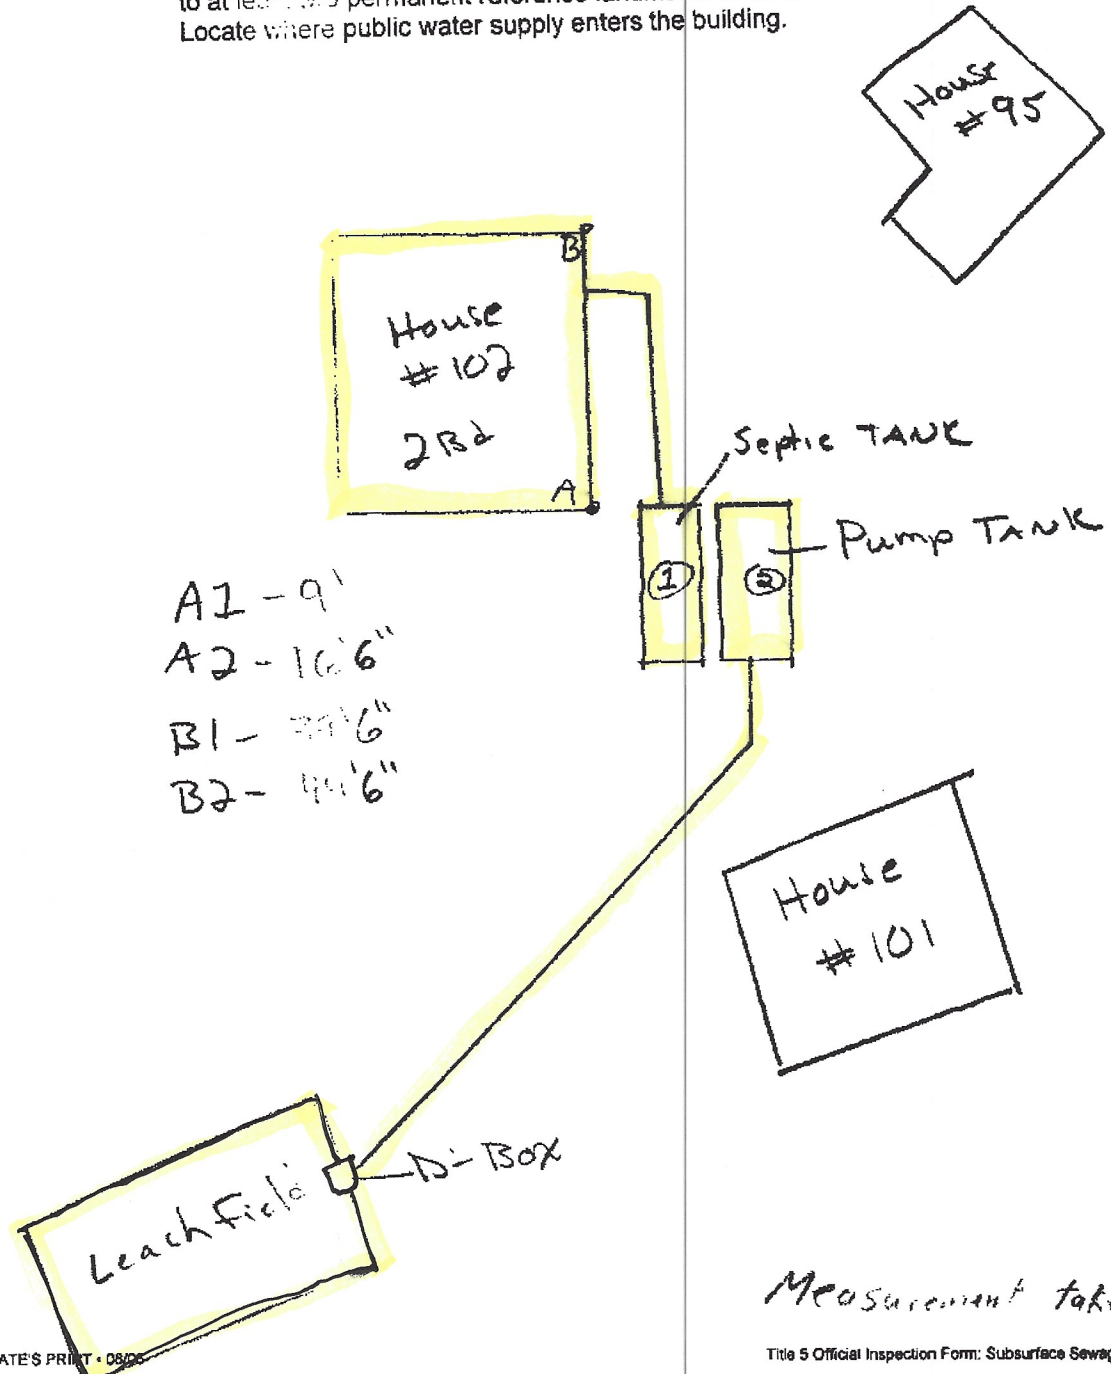

Measurement taken from Plans