


Unit # 104 - Septic Map

Note: No known drinking water sources within 100' radius.

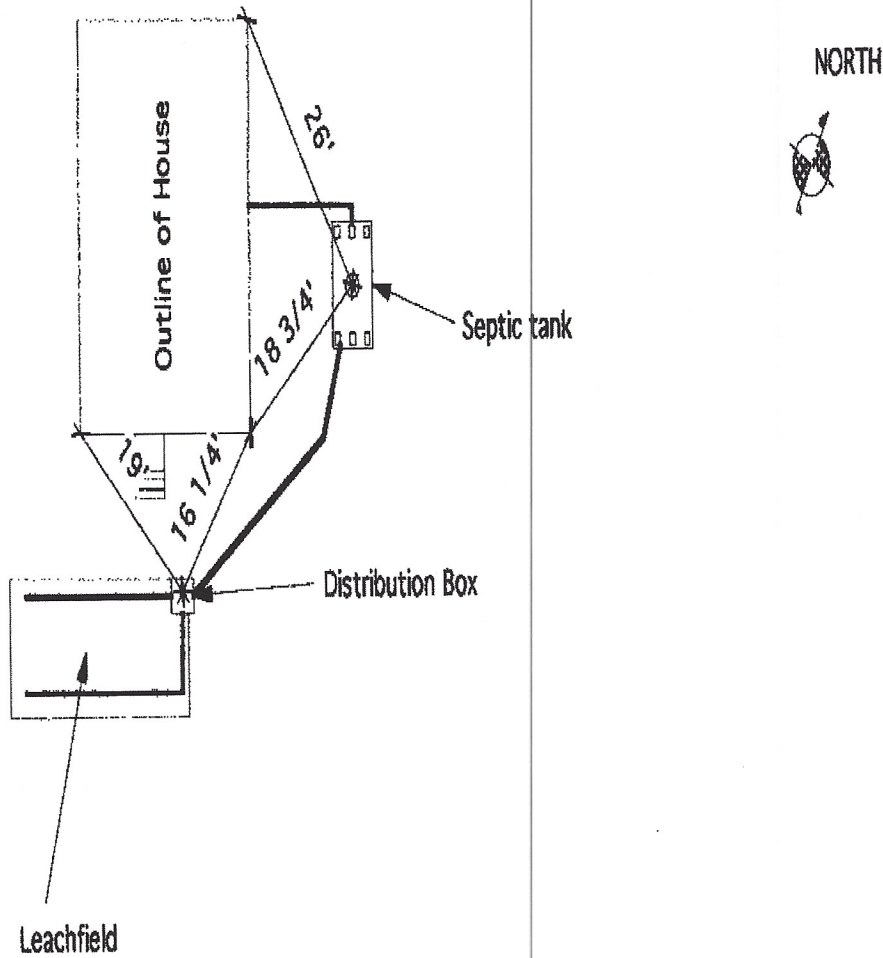

COMMENTS:

Recommend pumping on a 5 year schedule. Also, a copy of this plan posted in the basement/utility area would keep this information accessible in future years for maintenance.

As-Built Drawing Existing Septic System	Date: 9/10/04	Owner: Rosemarie R. James 104 Laurel Park Northampton, MA 01060		HOMESTEAD INC. Thomas S. Leue R.S. 1664 Cape St. Williamsburg, MA 01096 [413] 628-4533
Scale: 1 : 20' Except as Noted	Revision Date:			