


Septic & Leach Field Map

#105 Laurel Park

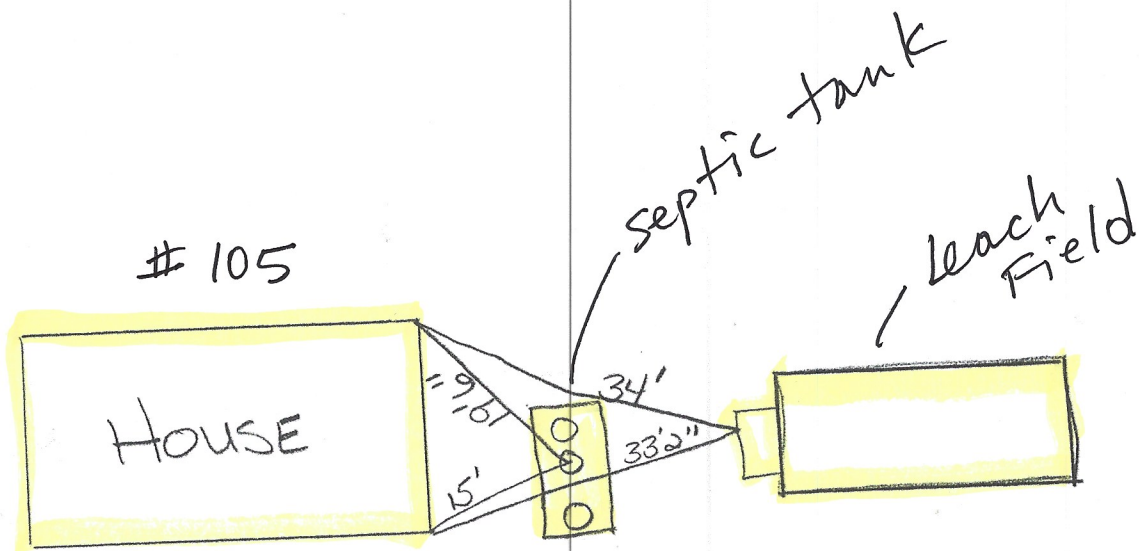

247.9808 Cotton's
As-built for:
Kathy Whynott
105 Laurel Park
Northampton, MA
June, 2001