


SEPTIC MAP  
 # 106 and # 108  
 (shared septic)

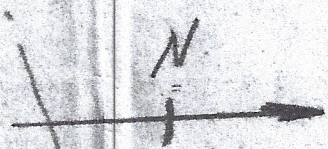

INSTALLATION NO.

- 1 ALL CONSTRUCTION TO BE WITH 310 CMR 15 TITLE BOARD OF HEALTH REGO
- 2 SEPTIC TANK TO HAVE TEES IN ACCORDANCE SECTION 8, 9
- 3 SEPTIC TANK AND CL SET LEVEL ON COMP
- 4 ALL PIPE TO BE SCH 40 DUE TO SOIL CONDITIONS CROSSING
- 5 OLD TANK TO BE PUMP

1/2" pipe

