


**SEPTIC MAP**  
**# 106 and # 108**  
**(Shared Septic)**

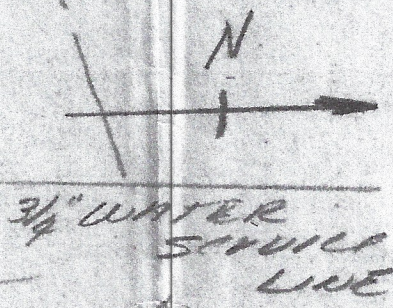

3/4" WATER SERVICE LINE

ALLOW PLASTIC STORMS SEWER

DIST BOX SCOPE CHANGE IN PIPE + CLEAN OUT

NSA FULL COVER

INSTALLATION NOTES

- 1 ALL CONSTRUCTION TO BE WITH 310 CMR 15 TITLE BOARD OF HEALTH REGULATIONS
- 2 SEPTIC TANK TO HAVE TESTS IN ACCORDANCE SECTION 8, 9
- 3 SEPTIC TANK AND CHAMBER TO BE SET LEVEL ON COMPASS
- 4 ALL PIPE TO BE SCHEDULE 40 DUE TO SOIL CONDITIONS CROSSING
- 5 OLD TANK TO BE PUMPED OUT

