

Unit # 109 - Septic Map



Commonwealth of Massachusetts
Title 5 Official Inspection Form
Subsurface Sewage Disposal System Form - Not for Voluntary Assessments

109 LAUREL PARK
Property Address
DAN RICHARDSON
Owner's Name
NORTHAMPTON MA 01060 10/27/2014
City/Town State Zip Code Date of Inspection


Owner information is required for every page.

D. System Information (cont.)

Sketch Of Sewage Disposal System: Provide a view of the sewage disposal system, including ties to at least two permanent reference landmarks or benchmarks. Locate all wells within 100 feet. Locate where public water supply enters the building. Check one of the boxes below:

- hand-sketch in the area below
- drawing attached separately

SEE ATTACHED PLAN

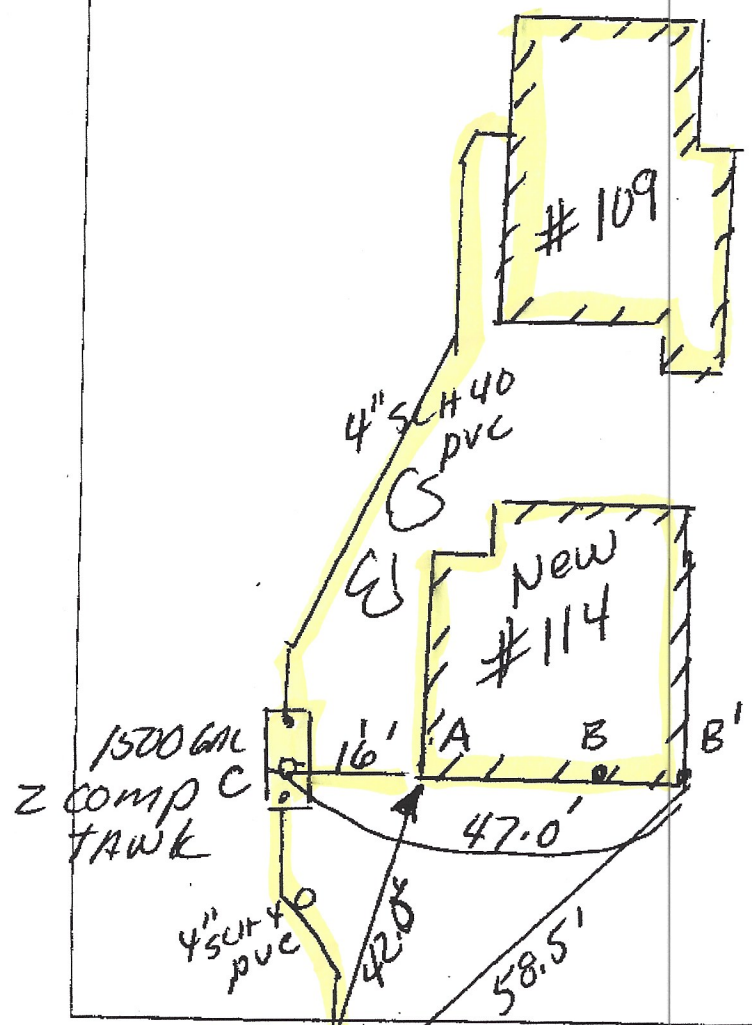

AS BUILT TIES FROM
NEW BLDG
2014

AC: 16.0
B'C 47.0 SEPTIC TANK

AD 42.5'
B'C 58.5' DIST BOX

2-38' TRENCHES
D DIST BOX